


DATE 3/8/59

TOWN OF LEXINGTON — BOARD OF PUBLIC WORKS

WATER DIVISION

Sketch of Service Here

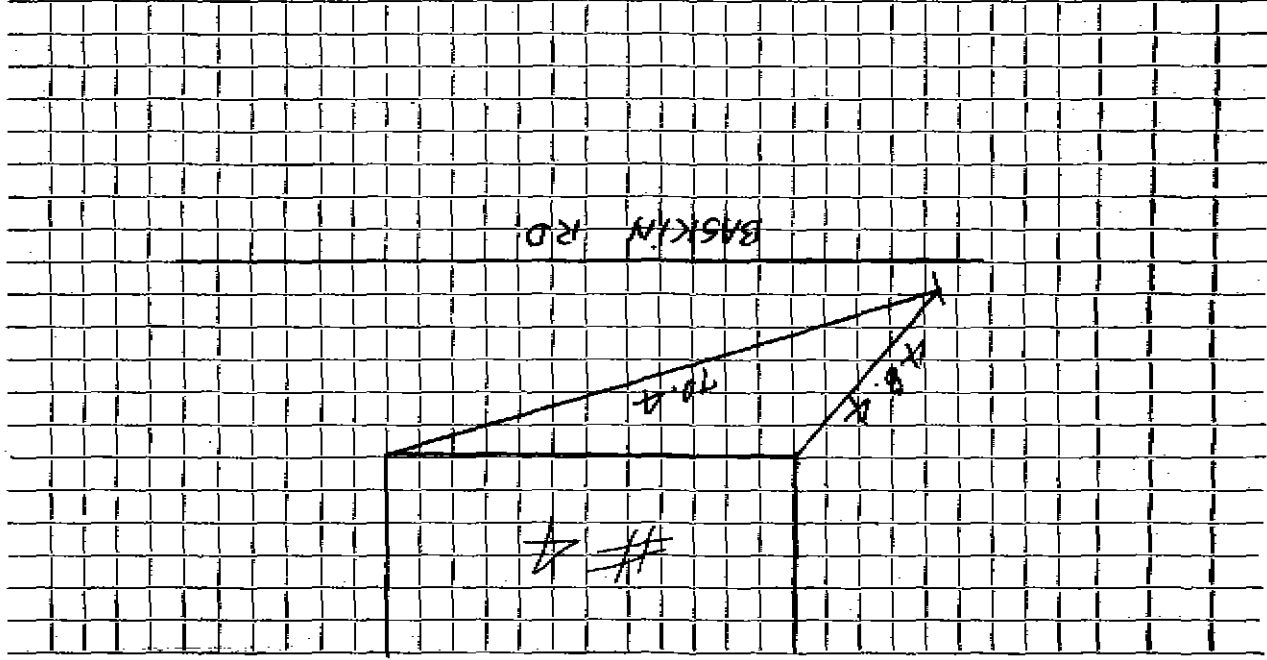

Work completed

Street

BASKIN RD.

Connection made in

Remarks: