

## WATER SERVICE RECORD

#2792

Service No. 122

Name Raymond F. Boudreau

Address 41 Baskin Road

Location Lot #79 Sta 24/46

Remarks ~~Renewal~~ New Service

W O # 2588

Cm. 12-10-62


Date	Material	Amount	Total	Date	Amount	
7/26/61	Labor	2 04		9-13-62	Deposit	250 00
	10% O.H.	20	2 24	12-10-62	ReFund	17 06
	14' 3/4" Copper tubing @.42		5 88			232 94
	BILL WHEN CONNECTED		8 12			
9-19-62	Labor	39.02		7/26/61	Labor	2 04
	10% O.H.	3.90	42.92	9'	3/4" Copper tubing @.42	3 78
259'	1" Copper tubing @56		145.04	1	3/4" G Corp Cock	4 91
5	1" 3 Part Unions @3.98		19.90	1	3/4" G Curb Cock	6 28
1	Hr. Trucking @3.00		3.00	1	Box & Rod	4 90
1	1"X1" W. H. Stop & Waste		6.96			21 91
7	X 3 Patch		7.00			
			232.94			

Applied to SHC # 175

TOWN OF LEXINGTON — BOARD OF PUBLIC WORKS

WATER DIVISION

Sketch of Service Here

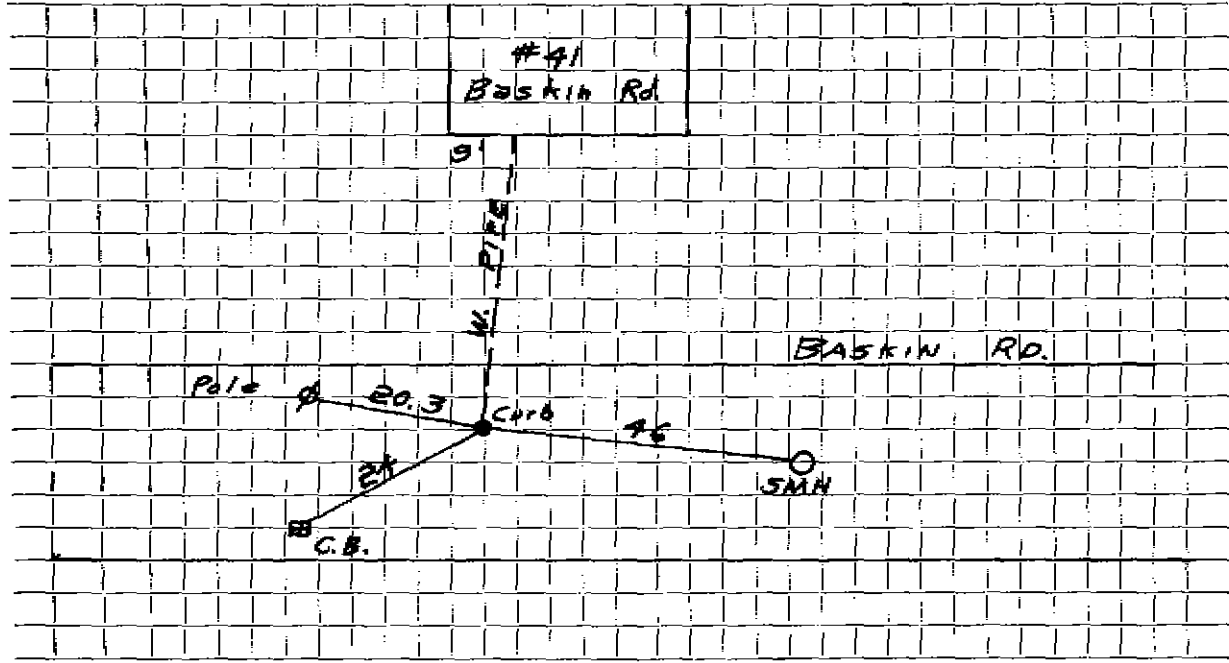

Connection made in ..... Street. Work completed .....

Remarks: .....  
.....  
.....