

## WATER SERVICE RECORD

Name Outhet Realty Trust

Service No. 180

Address 42 Basking Road

Location Lot #68 Sta 24/85

~~Renewal~~ ~~Renewal~~ - New Service

Comm 12-18-61


Date	Material	Amount	Total	Date	Material	Amount
7/26/61	Labor	2 04		10/31/61	Deposit	75 00
	10% O.H.	20	2 24	12-18-61	Refund	23 45
	11' 3/4" Copper tubing @.42		4 62			51 55
	BILL WHEN CONNECTED		6 86			
11/17/61	Labor	4 19		7/26/61	Labor	2 04
	10% O.H.	42	4 61		20' 3/4" Copper tubing @.42	8 40
	75' 3/4" Copper Tubing @ .42		31 50		1 3/4" G Corp Cock	4 91
	1 3/4" Cx 1/2 IWH Stop & Waste		6 17		1 3/4" G Curb Cock	6 28
	1 3/4" G3 part Union		2 41		1 Box & Rod	4 90
	Previous Charge		6 86			26 53
			51 55	11/17/61	1 1/2 Straight Tailpiece	50
					1 1/2 Offset Tailpiece	50
						27 53

DATE \_\_\_\_\_

TOWN OF LEXINGTON — BOARD OF PUBLIC WORKS

**WATER DIVISION**

Sketch of Service Here

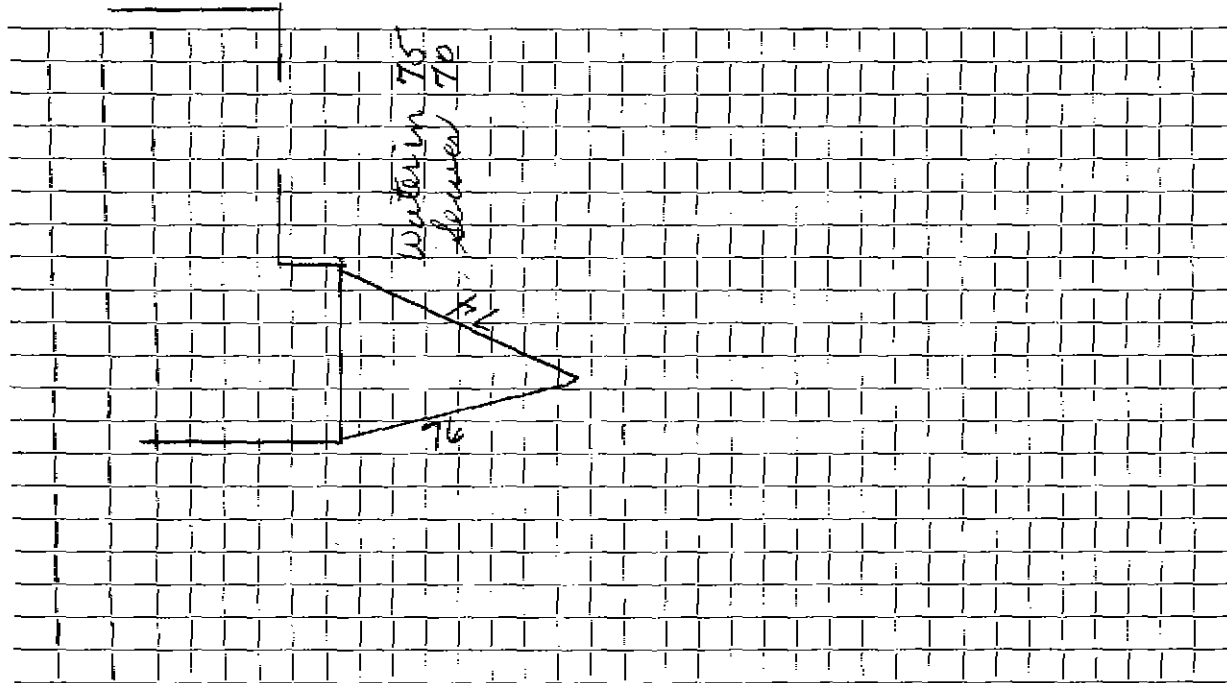

Connection made in ..... Street: ..... Work completed .....

Remarks: .....

.....  
.....