

WATER SERVICE RECORD

#3334

Name Outhet Realty Trust

Service No. 206

Address 45 Baskin Road

Location Lot #B1 Sta 26-73

Remarks ~~REMOVE~~ - New Service

WC# 7003

Comm 2-26-62


Date	Material	Amount	Total	Date	Amount	
7/26/61	Labor	2 04		12-11-61	Deposit	50 00
	10% O.H.	20	2 24	2-26-62	Paid by SHC# 196	5 47
	12' 3/4" Copper tubing @.42		5 04			55 47
	BILL WHEN CONNECTED		7 28			
12-14-61	Labor	4.04		7/26/61	Labor	2 04
	10% O.H.	.40	4.44	9'	3/4" Copper tubing @.42	3 78
	78' 3/4" Copper tubing @.42		32.76	1	3/4" C Corp Cock	4 91
	1 3/4" C x 1/2 I.W.H. Stop & Waste		6.17	1	3/4" C Curb Cock	6 28
	2 3/4" C 3 part union @2.41		4.82	1	Box & Rod	4 90
			55.47			21 91

DATE _____

TOWN OF LEXINGTON — BOARD OF PUBLIC WORKS

WATER DIVISION

Sketch of Service Here

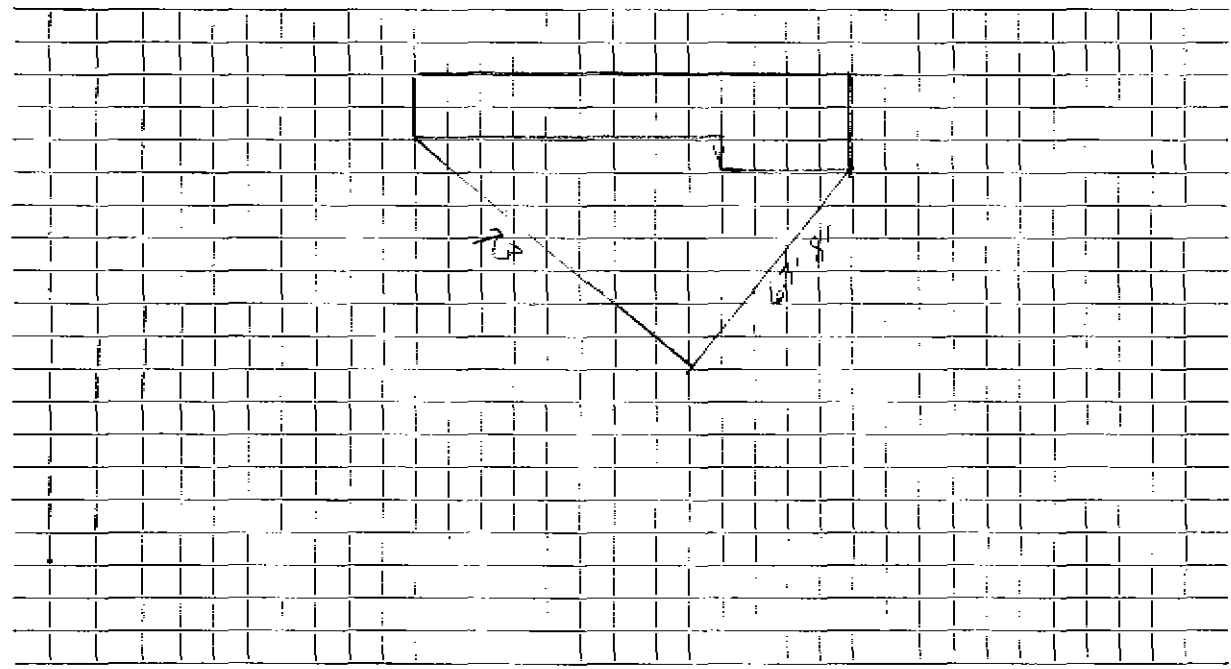

Connection made in Street. Work completed

Remarks:
.....
.....