

WATER SERVICE RECORD

#5255

Name Outhet Realty Trust

Service No. 191

Address 46 Baskin Road

Location Lot #67 Sta 26/80

~~RENEWAL~~ RENEWAL - New Service


Lic # 6979

Comm 2-26-62

Date	Material	Amount	Total	Date	Amount	
7/25/61	Labor	2 04		11-30-61	Deposit	50 00
	10% O.H.	20	2 24	2-26-62	Paid by SHE# 184	20 76
	6' 3/4" Copper tubing @ .42		2 52			70 76
	BILL WHEN CONNECTED		4 76			
12/5/61	Labor	4 19		7/25/61	Labor	2 04
	10% O.H.	42	4 61			
	120' 3/4" Copper Tubing @ .42		50 40	21'	3/4" Copper tubing @ .42	8 82
	1 3/4" Cx 1/2 IWH Stop & Waste		6 17	1	3/4" C Corp Cock	4 91
	2 3/4" C3 Part Unions @ 2.41		4 82	1	3/4" C Curb Cock	6 28
	PREVIOUS CHARGE		4 76	1	Box & Rod	4 90
			70 76			26 95
				12/5/61	1 1/2 Straight Tailpiece	50
					1 1/2 Offset Tailpiece	50
						27 95

TOWN OF LEXINGTON — BOARD OF PUBLIC WORKS
WATER DIVISION

Sketch of Service Here

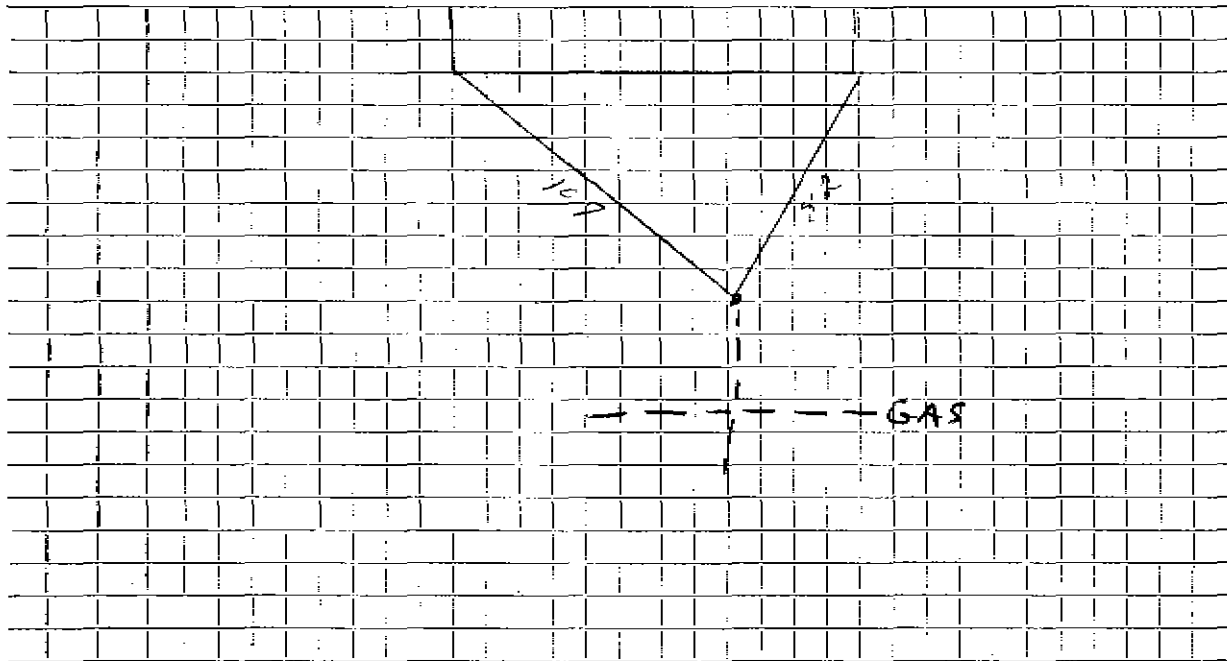

Connection made in Street. Work completed

Remarks: *Gas crosses WATER SERVICE IN ST. 4' down to Gas. water inside Gas 4' deep.*