

WATER SERVICE RECORD

Name Ernest E. Outhet

Service No. 21

Address 17 Baskin Road

Location Lot # 82 Sta 27/87

RIGID EXHAUST - New Service

C # 2837

Comm 5-27-63


Date	Material	Amount	Total	Date	Material	Amount
7/26/61	Labor	2 04		7-11-63	Deposit	50 00
	10% O.H.	20	2 24	5-27-63	Paid by SHC # 24	10 40
9'	3/4" Copper tubing @.42		3 78			60 40
	BILL WHEN CONNECTED		6 02			
4-17-63	Labor	4.44		7/26/61	Labor	2 04
	10% C.H.	.45	4.89	12'	3/4" Copper tubing @.42	5 04
80'	3/4" Copper tubing @.42		33.60	1	3/4" C Corp Cock	4 91
1	3/4" C x 1/2 I.W.H. Stop & Waste		6.17	1	3/4" C Curb Cock	6 28
2	3/4" C 3 part unions @2.41		4.82	1	Box & Rod	4 90
1	Box & Rod		4.90			23 17
			60.40	1	Offset tailpiece	.50
				1	Straight tailpiece	.50
						24.17

DATE _____

TOWN OF LEXINGTON — BOARD OF PUBLIC WORKS

WATER DIVISION

Sketch of Service Here

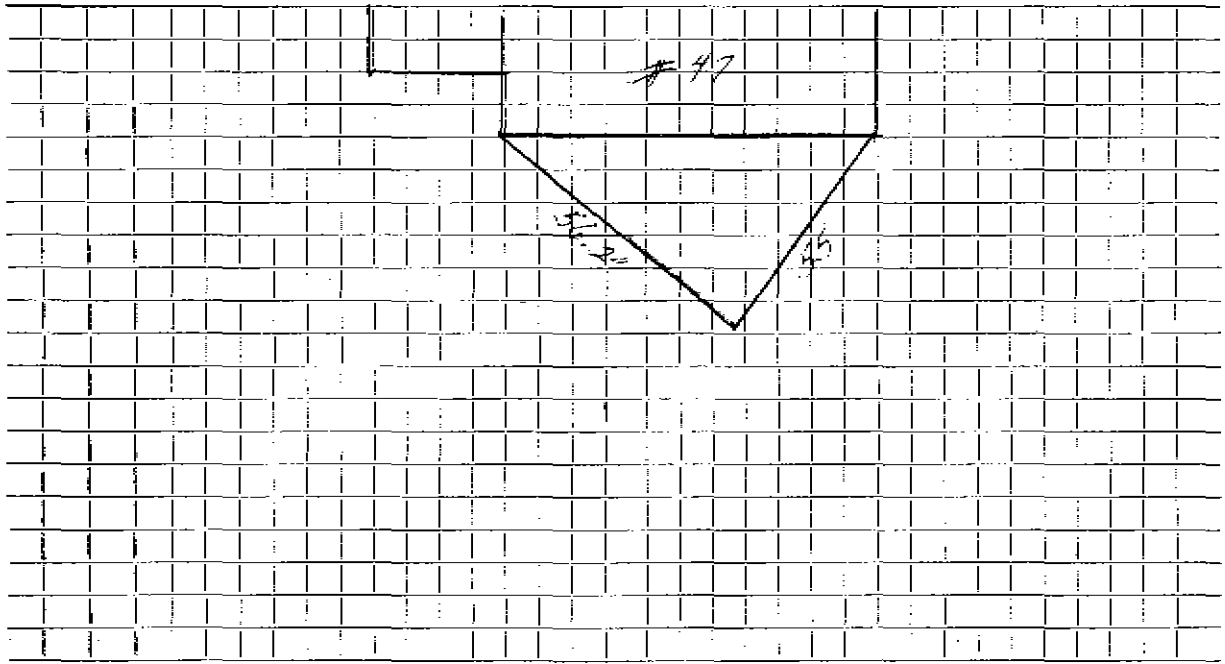

Connection made in Street. Work completed

Remarks:
.....
.....