

## WATER SERVICE RECORD


Name Emile SaulnierService No. 140Address 46 Baskin RoadLocation Lot #33 Sta. 29+09~~Repair~~ ~~Renewal~~ New ServiceComm 12-4-61

Date	Material	Amount	Total	Date		Amount
7-29-61	Labor	2.04		9-24-61	Deposit	.50 00
	10% O.H.	.20	2.24	12-4-61	Paid by SHC #131	1 90
	12' 3/4" Copper tubing @.42		5.04			51 90
	BILL WALKER CONNECTION		7.28		AC. SERVICE	
10-4-61	Labor	2.32		9-29-61	Labor	2.04
	10% O.H.	.23	2.55	9' 3/4" Copper tubing @.42		3.78
	74' 3/4" Copper tubing @.42		31.08	1 3/4" G Corp Cook		4.01
	1 3/4" G x 1/2 I.W.H. Stop & Waste		6.17	1 3/4" G Curb Cook		6.28
	2 3/4" G 3 part unions @2.41		4.82	1 Box 2 Rod		4.80
			44.62			21.91
				1 1/2 Straight tailpiece		.50
				1 1/2 Offset tailpiece		.50
						22.91

DATE \_\_\_\_\_

TOWN OF LEXINGTON — BOARD OF PUBLIC WORKS  
WATER DIVISION

Sketch of Service Here

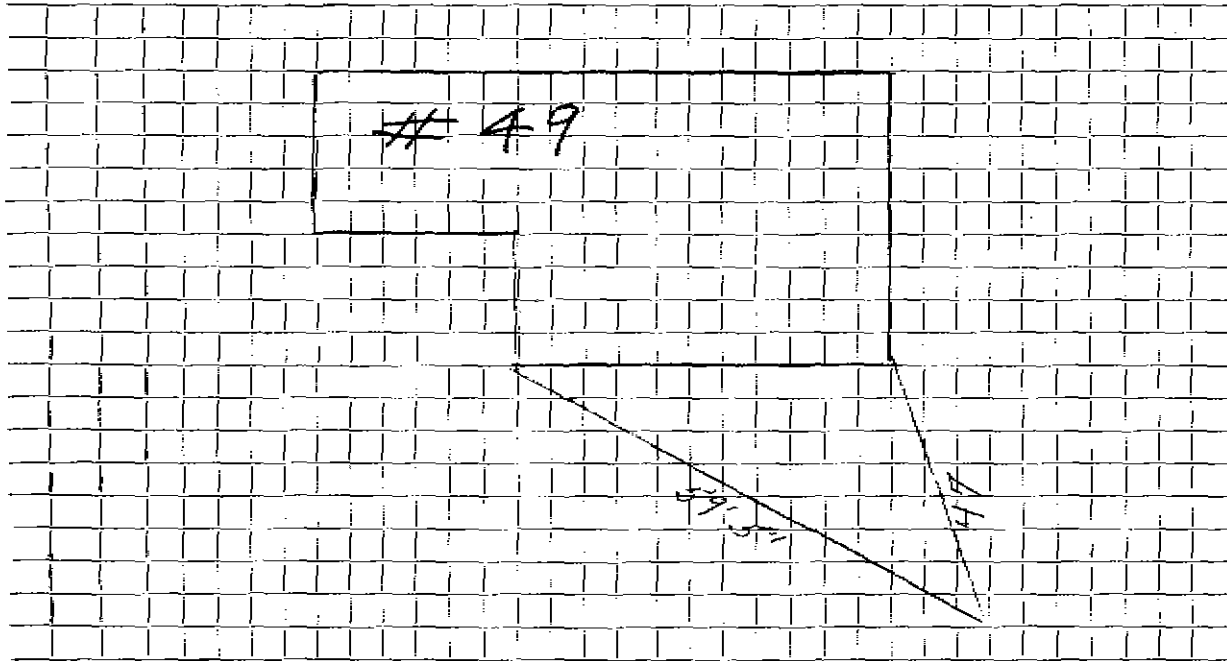

Connection made in BASKIN RD Street. Work completed .....

Remarks: .....  
.....  
.....