

WATER SERVICE RECORD

Name **Mark Moore**

Service No. **25**

Address **5 Baskin Road**

Location **Lot 23**

Repair—Renewal—New Service

Comm. 6-2-58


Date	Material	Amount	Total	Date	Material	Amount
3/12/58	Labor	4 10		3-10-58	Deposit	\$ 50 00
	10% overhead	41	4 54	6-2-58	Refund	17 55
	60' - 3/4" Copper tubing @ .37	22 20			NON CHARGE	\$ 32 45
	1 - 3/4" Cx 1/2 I.W.H. Stop & Waste	4 96		9/27/57	Labor	4 64
	1 hr. Trucking		75	12' - 3/4" Copper tubing		4 50
			32 45	1 3/4" C. Corp Cock		4 64
				1 3/4" C Curb Cock		5 94
				1 Box & Rod		4 62
						24 34
				3/12/58 - 1 - 1/2 Straight tailpiece		50
				1 - 1/2 Offset tailpiece		50
						25 34

DATE 3/8/59

TOWN OF LEXINGTON — BOARD OF PUBLIC WORKS

WATER DIVISION

Sketch of Service Here

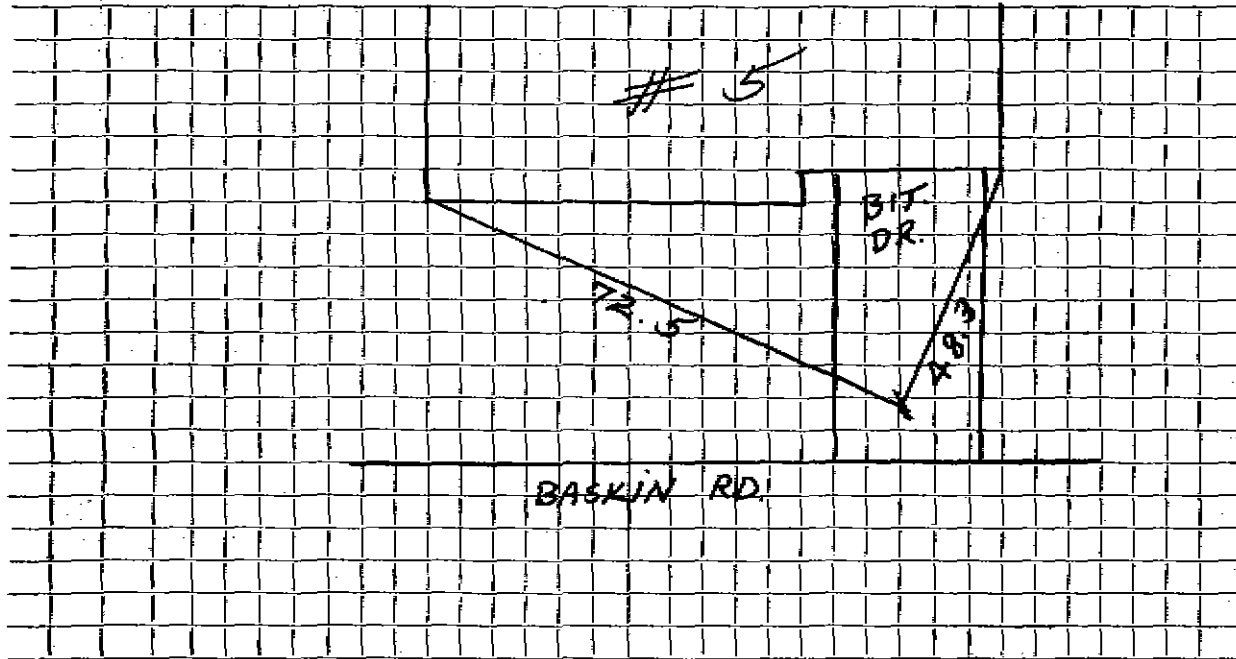

Connection made in BASKIN RD. Street. Work completed

Remarks:
.....
.....