

## WATER SERVICE RECORD

# 4354  
# 679

Name A. J. Comeau Const.

Service No. 61

Address 51 Baskin Road

Location Lot # 84 Sta 30/56

Repair New Service W.C. # 7304


Com 7-16-62

Date	Material	Amount	Total	Date	Amount
7/26/61	Labor	2 04		5/22/61	Deposit
	10% O.H.	20	2 24	7/26/62	A Refund
	17' 3/4" Copper tubing @ .42		<u>7 14</u>		45.95
	BILL WHEN CONNECTED		9 38		
5/29/62	Labor	4 06		7/26/61	Labor
	10% O.H.	41	4 47	8'	3/4" Copper tubing @ .42 3 36
	56' 3/4" Copper Tubing @ .42		23 52	1	3/4" C Corp Cock 4.91
	1 3/4" Ox $\frac{1}{2}$ IWH Stop & Waste		6 17	1	3/4" C Curb Cock 6.28
	1 3/4" 03 Part Union		2 41	1	Box & Rod 1.90
			45 95		21 49
			5/29/62	Service was in	
				1 $\frac{1}{2}$ Offset Tailpiece	50
				1 $\frac{1}{2}$ Straight Tailpiece	50
					22 49
				<i># Applied to S.H.C. # 7304</i>	

DATE \_\_\_\_\_

TOWN OF LEXINGTON — BOARD OF PUBLIC WORKS  
WATER DIVISION

Sketch of Service Here

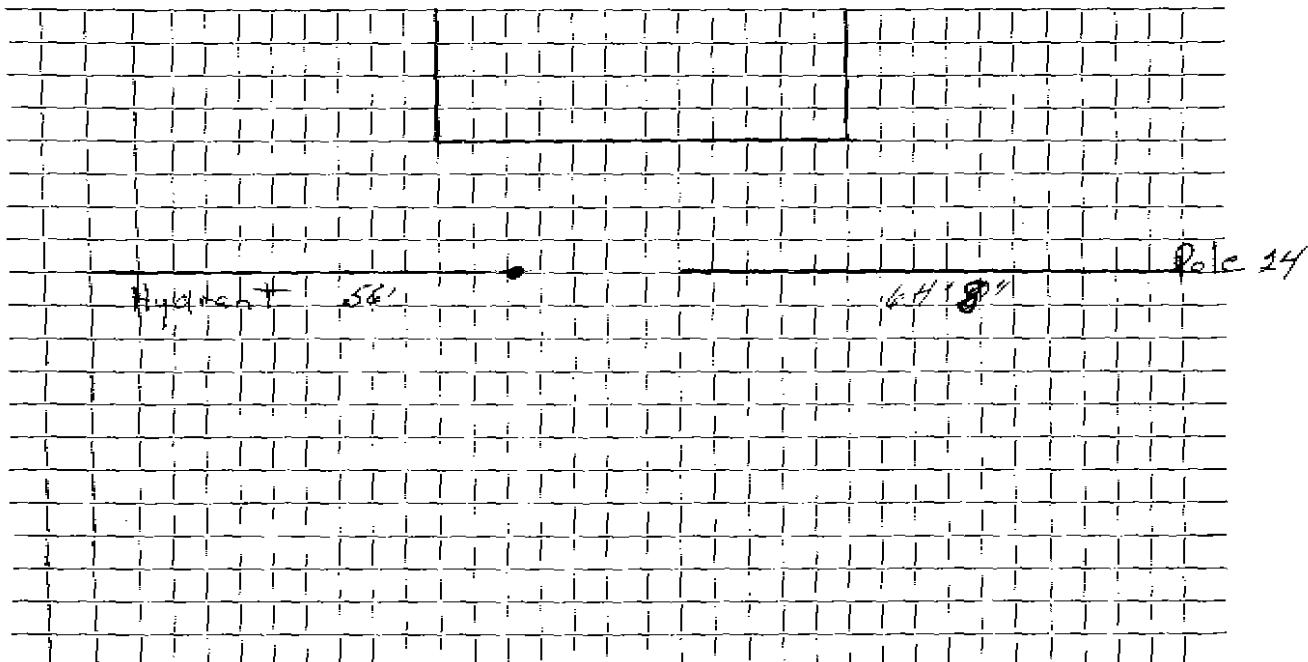

Connection made in ..... Street. Work completed .....

Remarks: .....

.....

.....