

WATER SERVICE RECORD

#5435

Name Arthur T. Bernier

Service No. 66

Address 54 Baskin Road

Location Lot #61

~~Repair~~ ~~Renewal~~ New Service

Comm 6-19-61


Date	Material	Amount	Total	Date	Material	Amount
5-20-60	Labor	1.94		5-26-61	Deposit	50.00
	10% O.H.	.19	2.13	6-17-61	Paid by SHC #38	4.10
8'	3/4" Copper tubing @.42		3.36			54.10
	<u>BILL WHEN CONNECTED</u>		5.49		<u>NON CHARGE</u>	
6-6-61	Labor	3.65		5-20-60	Labor	11.94
	10% O.H.	.37	4.02	28'	3/4" Copper tubing @.42	11.76
80'	3/4 Copper Tubing @.42		33.60	1	3/4" C Corp Cock	4.91
1	3/4" c x 1/2 I.W.F. Stop & Waste	6.17		1	3/4" C Curb Cock	6.28
2	3/4" c3 part unions @2.41	4.82	4.82	1	Box & Rod	5.00
			54.10			28.89
				1 1/2	Straight tailpiece	.50
				1 1/2	Offset tailpiece	.50
						29.89

DATE _____

TOWN OF LEXINGTON — BOARD OF PUBLIC WORKS

WATER DIVISION

Sketch of Service Here

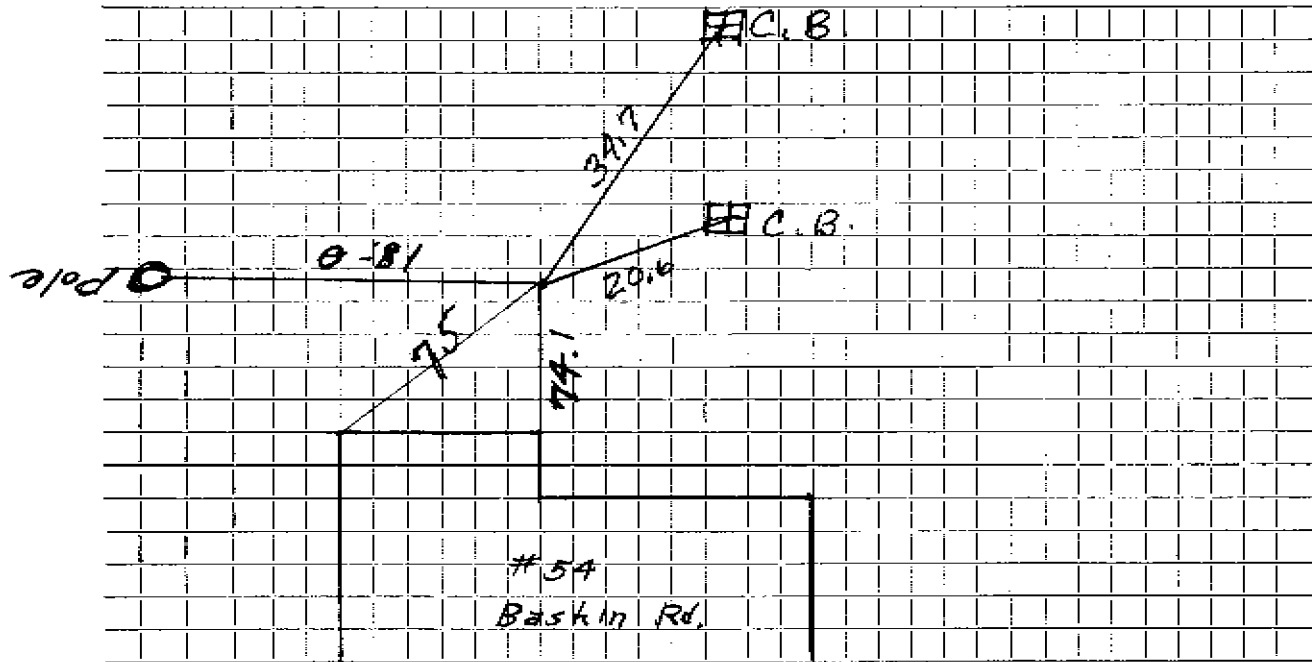

Connection made in Street. Work completed

Remarks:

.....

.....