

WATER SERVICE RECORD

Name Osmond Bros.

Service No. #90

Address <sup>56</sup>~~52~~ Baskin Road

2917  
#6683

Location Lot #~~62~~ 61

~~Repair/Removal~~ - New Service

WO# 2441


Comm 10-1-62

Date	Material	Amount	Total	Date		Amount
5-20-60	Labor	1.94		7-5-62	Deposit	50.00
	10% O.H.	.19	2.13	10-1-62	Paid by SHC# 1.00	4.19
	7' 3/4" Coppertubing @.42		2.94			54.19
	<u>BILL WHEN CONNECTED</u>		5.07		NON CHARGE	
7-12-62	Labor	4.02		5-20-60	Labor	1.94
	10% O.H.	.40	4.42	29'	3/4" Copper tubing@.42	12.18
	66' 3/4" Copper Tubing @.42		36.12	1	3/4" C Curb Cock	6.28
	1 3/4" CX 1/2 I.W.H. Stop & Waste		6.17	1	3/4" C Corp Cock	4.91
	1 3/4" C 3 Part Union		2.41	1	Box & Rod	5.00
			51.19			30.31

TOWN OF LEXINGTON — BOARD OF PUBLIC WORKS

WATER DIVISION

Sketch of Service Here

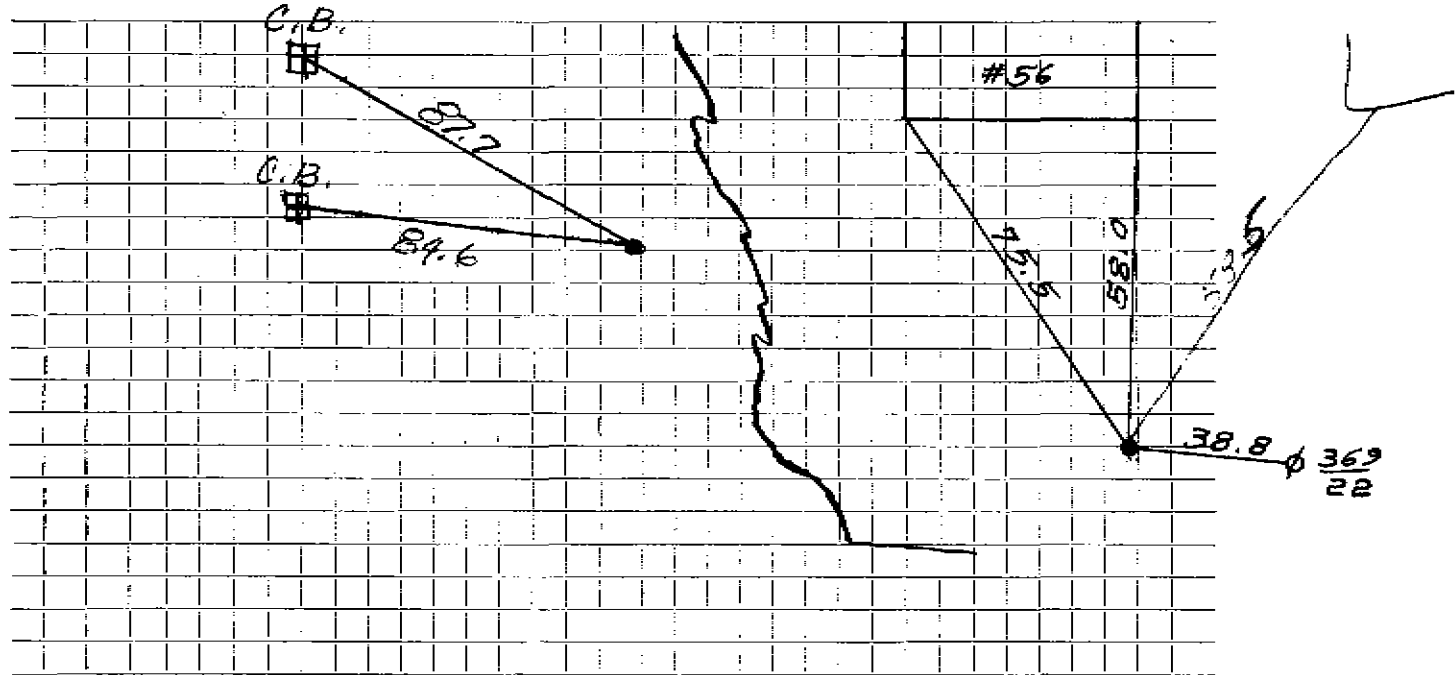

Connection made in ..... Street. Work completed .....

Remarks: .....

.....

.....