

## WATER SERVICE RECORD

Name John E. Lundquist

Service No. *# 1531*  
*# 1726*  
*34*

Address 57 Baskin Road

Location Lot #65


~~Repair-Renewal~~ New Service *Comm 5-5-61*

Date	Material	Amount	Total	Date	Material	Amount
5-21-60	Labor	1.94		5-11-61	Deposit	35.00
	10% O.H.	.19	2.13	5-8-61	Paid by 54111-18	24.46
	15' 3/4" Copper tubing @.42		6.30			59.46
	<u>BILL WHEN CONNECTED</u>		8.43		<u>NON CHARGE</u>	
4-12-61	Labor	2.04		5-21-60	Labor	1.94
	10% O.H.	.20	2.24	6'	3/4" Copper tubing @.42	2.52
	90' 3/4" Copper tubing @.42		37.80	1	3/4" C Corp Cock	1.91
	1 3/4" C x 1/2 I.P.K. Stop & Waste		6.17	1	3/4" C Curb Cock	6.28
	2 3/4" C 3 part unions @2.41		4.82	1	Box & Rod	5.00
			59.46			20.65
				1	3/8" Straight tailpiece	.50
				1	1/2" Offset tailpiece	.50
						21.65

TOWN OF LEXINGTON — BOARD OF PUBLIC WORKS

WATER DIVISION

Sketch of Service Here

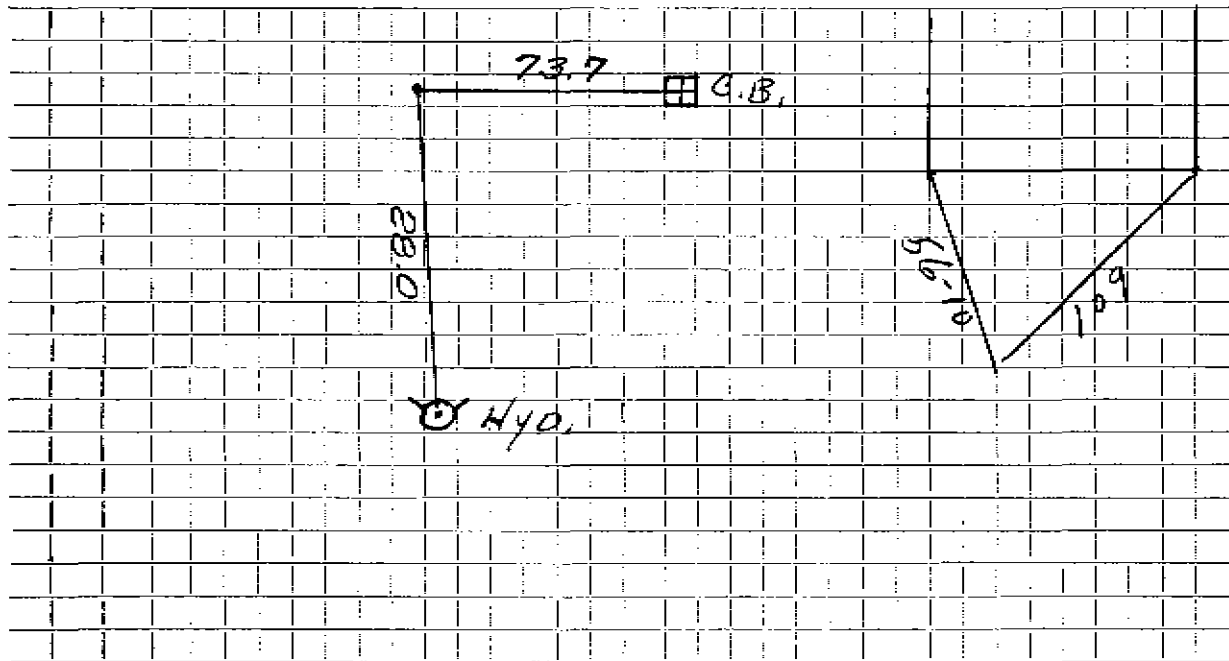

Connection made in ..... Street. Work completed .....

Remarks: .....

.....  
.....