

WATER SERVICE RECORD

2159 #5358
2190 Service No. 1

Name Moore Realty Trust

Address 58 Baskin Road

Location Lot #60

~~Repair - Renewal~~ New Service

Comm 3-6-61

Date	Material	Amount	Total	Date		Amount
5-21-60	Labor	1.94		1-4-61	Deposit	30.00
	10% O.H.	.19	2.13	3-17-61	Paid	16.62
	5' 3/4" Copper tubing @.42		2.10			40.62
	<u>BILL WHEN CONNECTED</u>		4.23		<u>NON CHARGE</u>	
1-5-61	Labor	1.94		5-21-60	Labor	1.94
	10% O.H.	.19	2.13	3/4'	3/4" Copper tubing @.42	11.28
	54' 3/4" Copper tubing @.42		22.68	1	3/4" C Corp Cock	4.91
	1 3/4" C x 1/2 I.M.W. Stop & Waste		6.17	1	3/4" C Curb Cock	6.28
	1 3/4" C 3 part union		2.41	1	Box & Rod	5.00
	1 hr. Trucking @3.00		3.00			32.41
			40.62	1	1/2 Offset tailpiece	.50
				1	1/2 Straight tailpiece	.50
						33.41


DATE _____

TOWN OF LEXINGTON — BOARD OF PUBLIC WORKS

WATER DIVISION

S Baskin RD Lex.

Sketch of Service Here

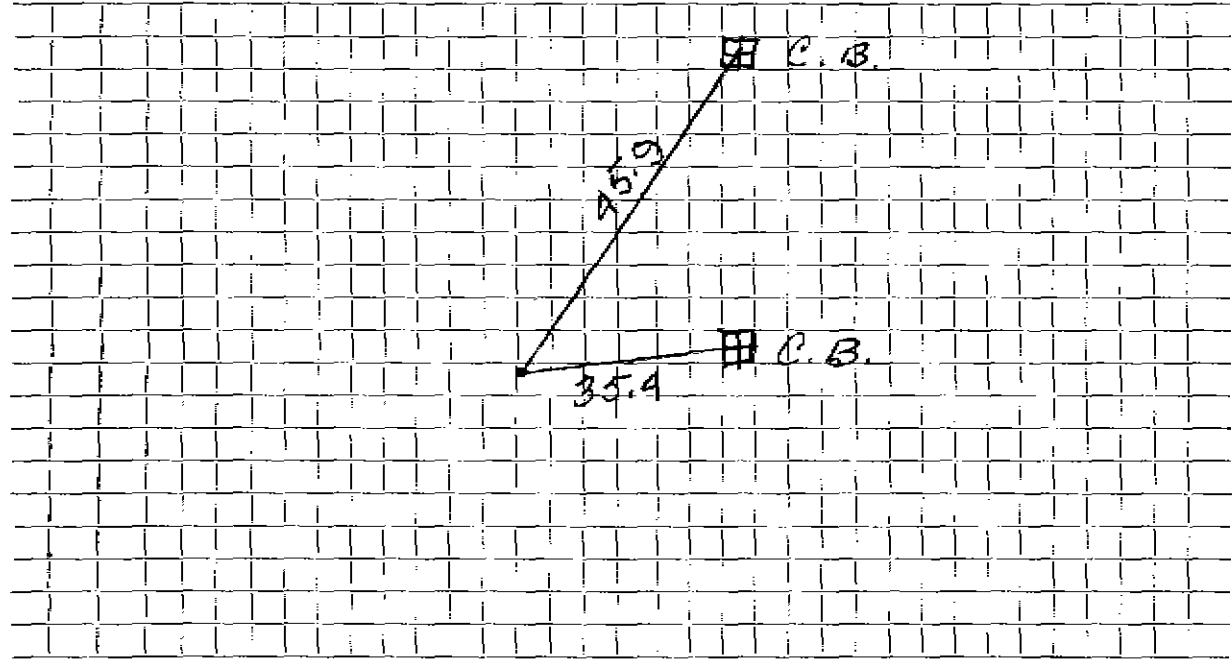

Connection made in Street. Work completed

Remarks:
.....
.....