

WATER SERVICE RECORD

Name Lexington Development Corp.

Service No. 12

Address 6 Baskin Road

Location Lot 3

~~Repair-Renewal-New Service~~


Comm. 6-2-58

Date	Material	Amount	Total	Date	Amount
3/13/58	Labor	3 72		1-23-58	Deposit \$ 50 00
	10% overhead	37	4 09	6-2-58	Refund * 18 00
	60' - 3/4" Copper tubing @ .37		22 20		\$ 32 00
	1 - 3/4" Cx 1/2 I.W.H. Stop & Waste		4 96		NON CHARGE
	1 hr. Trucking		75	9/27/57	Labor 4 63
			32 00	40' - 3/4" Copper tubing	15 00
				1 - 3/4" C. Corp Cock	4 64
				1 - 3/4" C. Curb Cock	5 94
				1 Box & Rod	4 62
					34 83
				3/3/58 1 - 1/2 Offset tailpiece	50
				1 - 1/2 Straight tailpiece	50
					35 83
				* \$ 2.85 applied to S.N.C #10	

DATE 3/8/59

TOWN OF LEXINGTON — BOARD OF PUBLIC WORKS  
WATER DIVISION

Sketch of Service Here

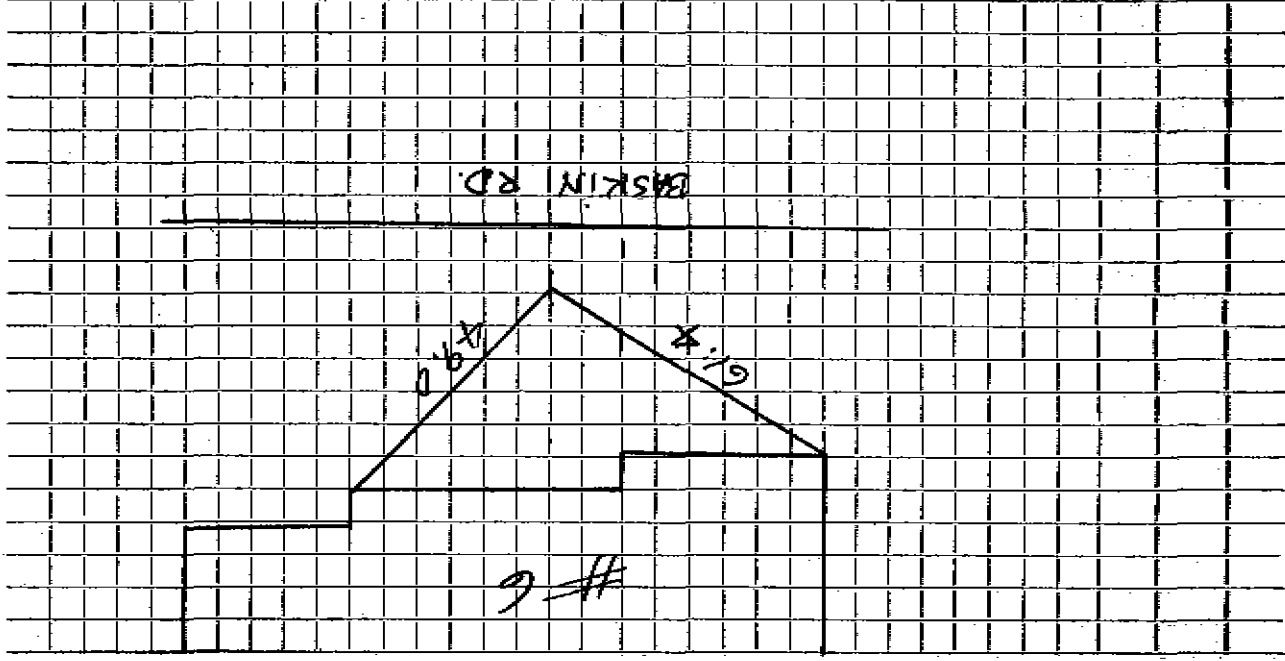

Connection made in BASKIN RD Street. Work completed

Remarks: