

WATER SERVICE RECORD

Name **Tricorn Homes, Inc.**

Service No. **16**

Address **60 Baskin Road**

Location **Lot #59**

~~Renewal~~ **New Service** WO #7085


Comm 5-28-62

Date	Material	Amount	Total	Date	Amount	
5-21-60	Labor	1.94		3-26-62	Deposit	35.00
	10% O.H.	.19	2.13	5-28-62	Paid by SHC #14	12.55
7'	3/4" Copper tubing @ .42	.42	2.94	6-12-62		4.28
	<u>BILL WHEN CONNECTED</u>		5.07		<u>NON CHARGE</u>	51.83
3/29/62	Labor	3.88		5-2-60	LABOR	1.94
	10% O.H.	.39	4.27	22'	3/4" Copper tubing @ .42	9.24
75'	3/4" Copper Tubing @ .42		31.50	1	3/4" C Corp Cock	1.91
1	3/4" Cx 1/2 IWH Stop & Waste		6.17	1	3/4" C Curb Cock	6.28
2	3/4" C3 Part Unions @ 2.41		4.82	1	Box & Rod	5.00
			46.76		Curb to Main	27.37
	<u>PREVIOUS CHARGE</u>		5.07	3/29/62	1 1/2 Straight Tailpiece	50
			51.83		1 1/2 Offset Tailpiece	50
						28.37

TOWN OF LEXINGTON — BOARD OF PUBLIC WORKS

WATER DIVISION

Sketch of Service Here

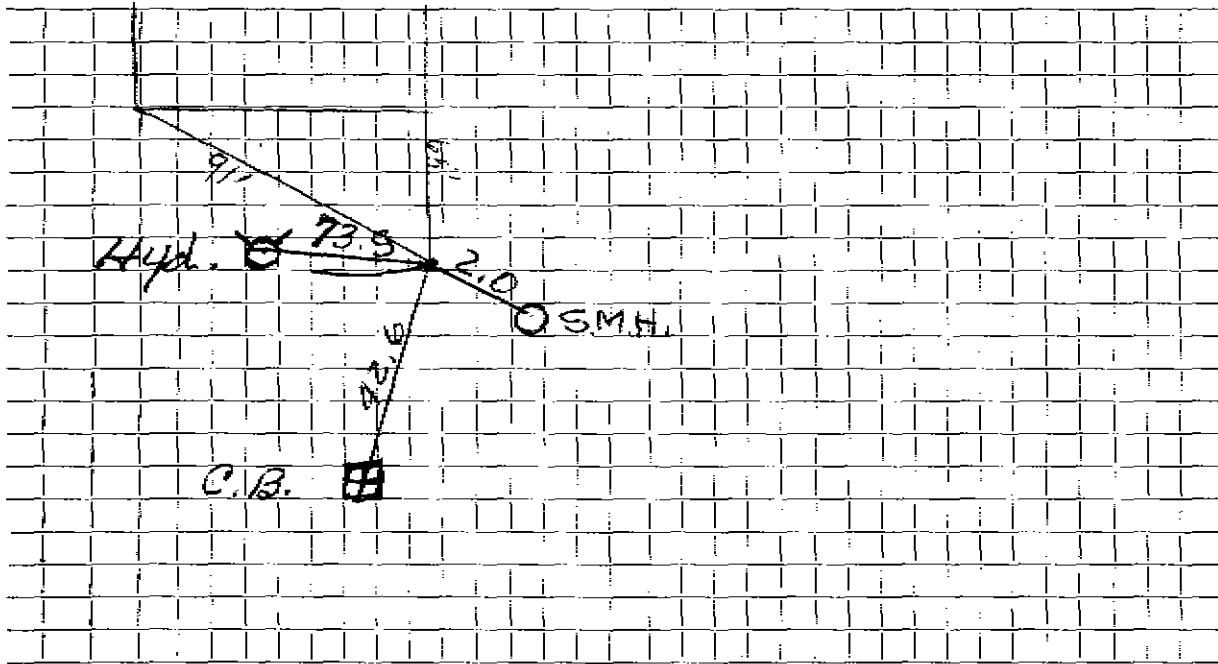

Connection made in ..... Street. Work completed .....

Remarks: .....  
.....  
.....