

WATER SERVICE RECORD

Name Parker Herlite

Service No. 99

Address 62 Baskin Road

Location Lot #58

~~Repair~~ ~~Renewal~~ New Service Kirkland and Shaw # 505


Comm 5-8-67

Date	Material	Amount	Total	Date	Material	Amount
5-21-60	Labor	1.94		5-13-67		
	10% O.H.	.19	2.13			
	4' 3/4" Copper tubing @.42		1.68			
	<u>BILL WHEN CONNECTED</u>		3.81			
			28.63	5-21-60	Labor	1.94
			32.44		25' 3/4" Copper tubing @.42	10.50
					1 3/4" C Corp Cock	4.91
					1 3/4" C Curb Cock	6.28
					1 Box & Rod	5.00
						28.63
12/15/66	55' 3/4" Copper					

TOWN OF LEXINGTON — BOARD OF PUBLIC WORKS

WATER DIVISION

Sketch of Service Here

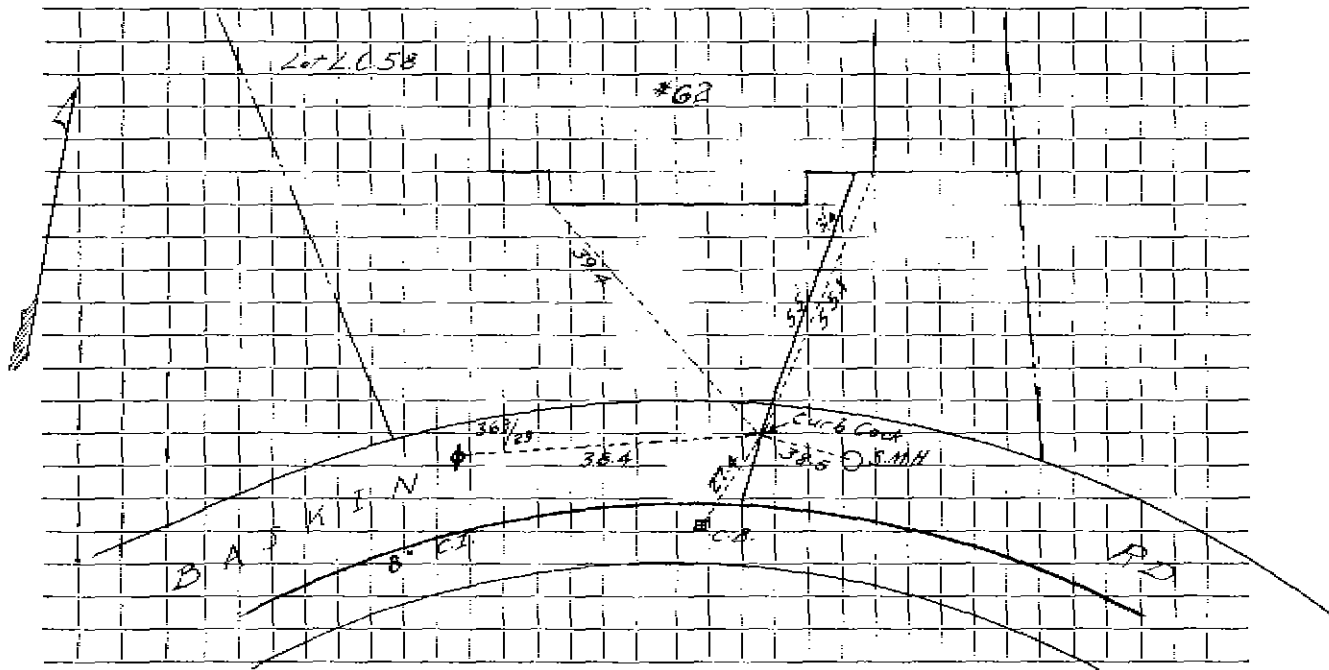

Connection made in Street. Work completed

Remarks:

.....
.....