

WATER SERVICE RECORD

Name Duthet Realty Trust

Service No. 83

Address 64 Baskin Ed.

Location

~~Repair~~ ~~Renewal~~ New Service

Cum 7-5-60


Date	Material	Amount	Total	Date	Amount
5-21-60	Labor	1 94		5-21-60	50 00
	"	1 94		7-5-60	13 21
		3 88			36 79
	10% O.K.	39	4 27		<u>NON CHARGE</u>
57'	3/4" Copper tubing 242		23 94		Labor
1	3/4" Cx 1/2 I.C.E. Stop Waste		6 17	21'	3/4" Copper tubing 242
1	3/4" C3 Part union		2 41	1	3/4" C Corp Sock
			36 79	1	3/4" C Carb Sock
				1	Box & Rod
				1 1/2	Straight tailpiece
				1 1/2	Offset tailpiece
					27 95

DATE _____

TOWN OF LEXINGTON — BOARD OF PUBLIC WORKS

WATER DIVISION

Sketch of Service Here

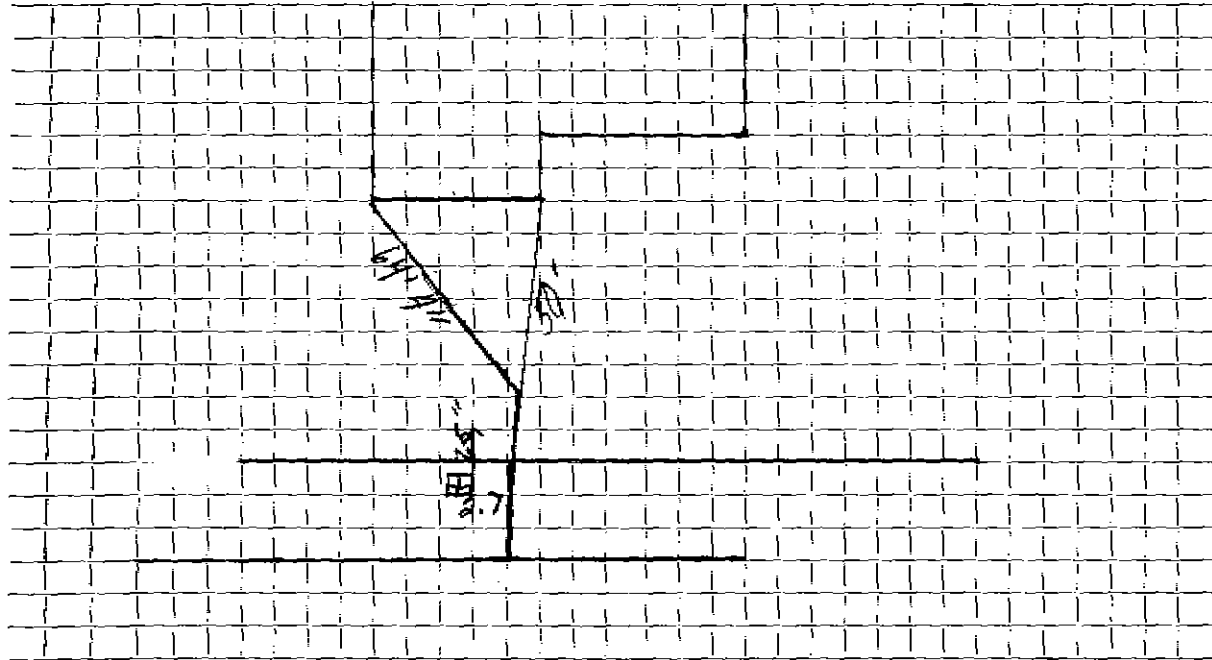

Connection made in Street. Work completed

Remarks: *Elev. 242.15 Sta. 374.53*

.....
.....