

WATER SERVICE RECORD

Name John F. Gallagher

Service No. 190

Address 65 Baskin Road

8829

Location Lot # 48

~~Repair~~ ~~Work~~ - New Service


Comm. 11-30-59

Date	Material	Amount	Total	Date	Amount
10-7-59	Labor	3.80		8-21-59	30.00
	10% O.E.	.38	4.18	11-30-59	2.32
64'	3/4" Copper tubing@	.41	26.24		39.32
1	3/4x1/2 I.W.E. Stop&Waste		5.88		
1	3/4" C3 Part Union		2.27		NON CHARGE
1	Hr. Trucking@	.75	.75		Labor
			39.32	1	1/2 Straight tailpiece .50
				1	1/8 Offset tailpiece .50
					1.00

DATE 3-18-87

TOWN OF LEXINGTON — BOARD OF PUBLIC WORKS
WATER DIVISION

Sketch of Service Here

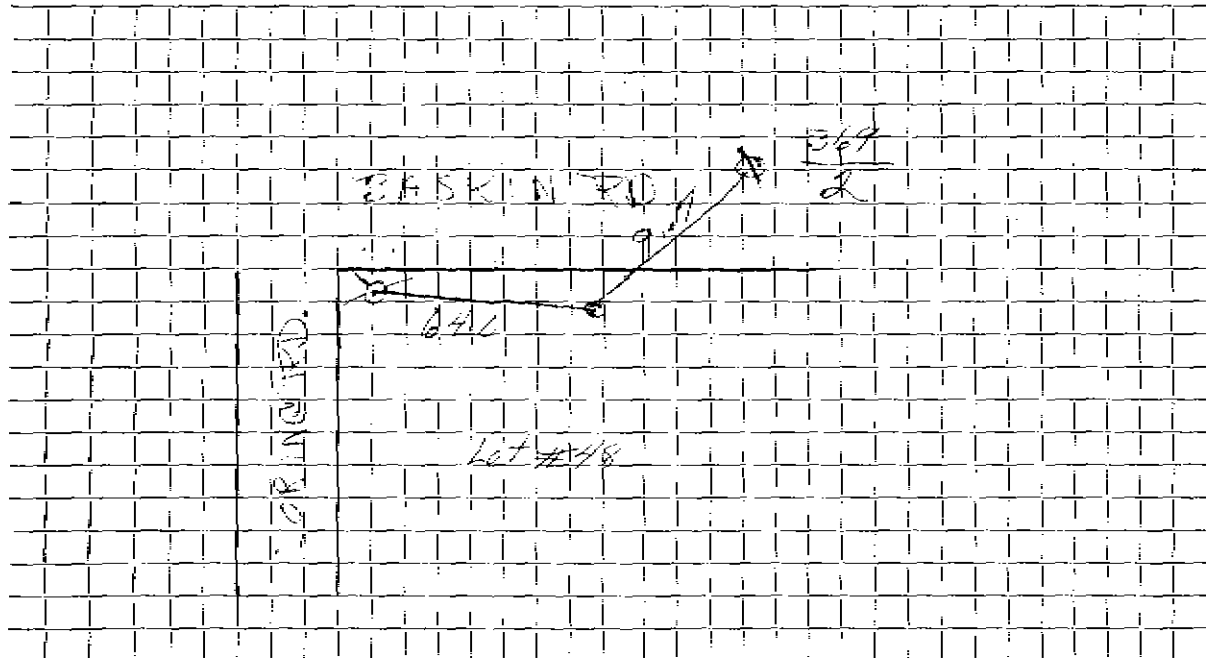

Connection made in Baskin Road Street. Work completed

Remarks:
.....
.....