

1569

## WATER SERVICE RECORD

Name Tricorn Homes, Inc.

Service No. #66

Address 66 Baskin Road

Location Lot ~~45~~ # 60~~Repair~~ ~~Renewal~~ New Service WO # 7338

Comm 10-1-62


Date	Material	Amount	Total	Date		Amount
6-15-62	Labor	3.83		6-4-62	Deposit	50.00
	10% O.H.	.38	4.21	10-1-62	Refund	5.71
75'	3/4" Copper tubing @.42		31.50			44.29
1	3/4" CX 1/2 I.W.H. Stop & Waste		6.17		NON CHARGE	
1	3/4" C3 Part Union		2.41	9-20-58	Labor	8.77
			44.29	32'	3/4" Copper tubing @.37	11.84
	OWNER DUG TRENCH			1	3/4" C Corp Cock	4.64
				1	3/4" C Curb Cock	6.03
				1	Box & Rod	5.00
						36.28
				6-15-62	1/2 Straight Tailpiece	.50
				1	1/2 Offset Tailpiece	.50
						37.28

DATE \_\_\_\_\_

# TOWN OF LEXINGTON — BOARD OF PUBLIC WORKS

## WATER DIVISION

Sketch of Service Here

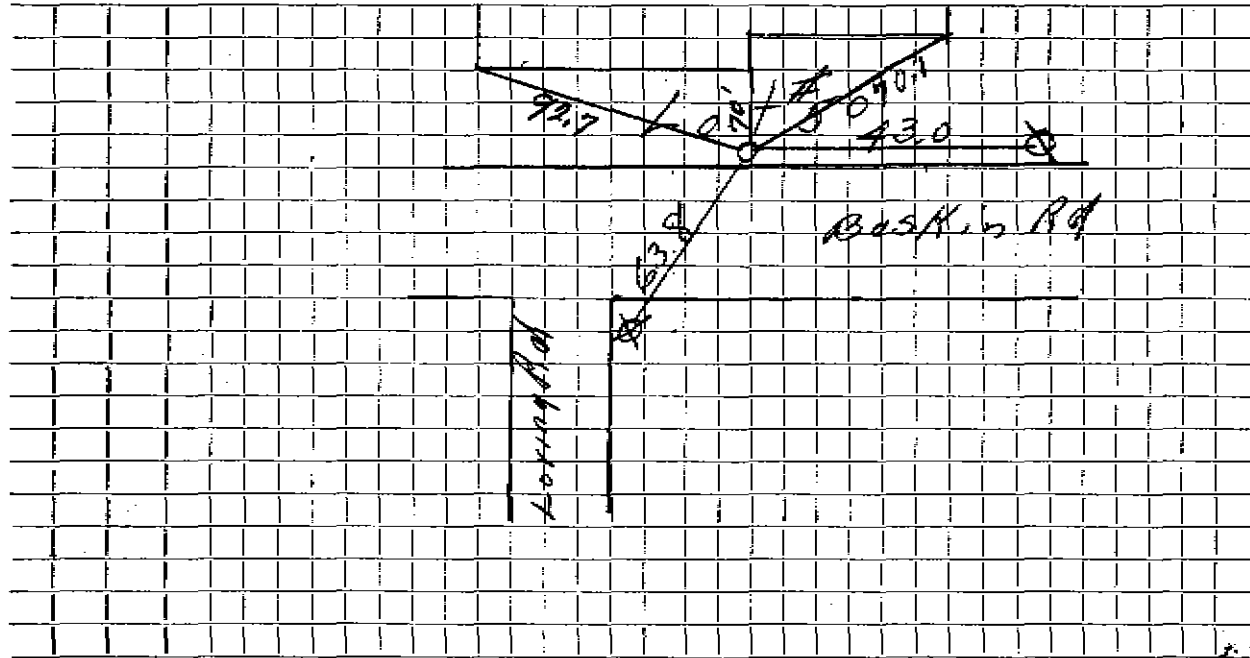

Connection made in ..... Street. Work completed .....

Remarks: .....

.....

.....