

5591

WATER SERVICE RECORD

Name Lexington Developing Corp.

Service No. 249

Address 67 Baskin Road

Location Lot # 49

~~Renewal~~ ~~Renewal~~ - New Service

Comm 12-14-59

Date	Material	Amount	Total	Date	Amount
9-13-58	Labor	9.17		10-5-59	Deposit 25.00
	10 % O.H.	.92	10.09	12-14-59	Paid by SMC # 194 11.15
	14' 3/4" Copper tubing @.37		5.18	1-8-61	Paid 10.13
	1 Hr. Trucking @.75	.75			NON CHARGE 46.28
	BILL WHEN CONNECTED		16.02		Labor 7.80
10/8/59	Labor	1.85		12' 3/4" Copper tubing @.37	4.44
	10% O.H.	.19	2.04	1 3/4" C Corp Cock	4.64
	46' 3/4" Copper tubing @.42	19.32		1 3/4" C Curb Cock	6.03
	1 3/4" Cx 1/2 IWH stop & waste	5.88		1 Box & Rod	5.00
	1 3/4" C 3 part Union	2.27			27.91
	1 hr. trucking	.75			
			30.26		
	total		46.28		


Bill sent 12-14-59 10.13

DATE 3/8/59

TOWN OF LEXINGTON — BOARD OF PUBLIC WORKS

WATER DIVISION

Sketch of Service Here

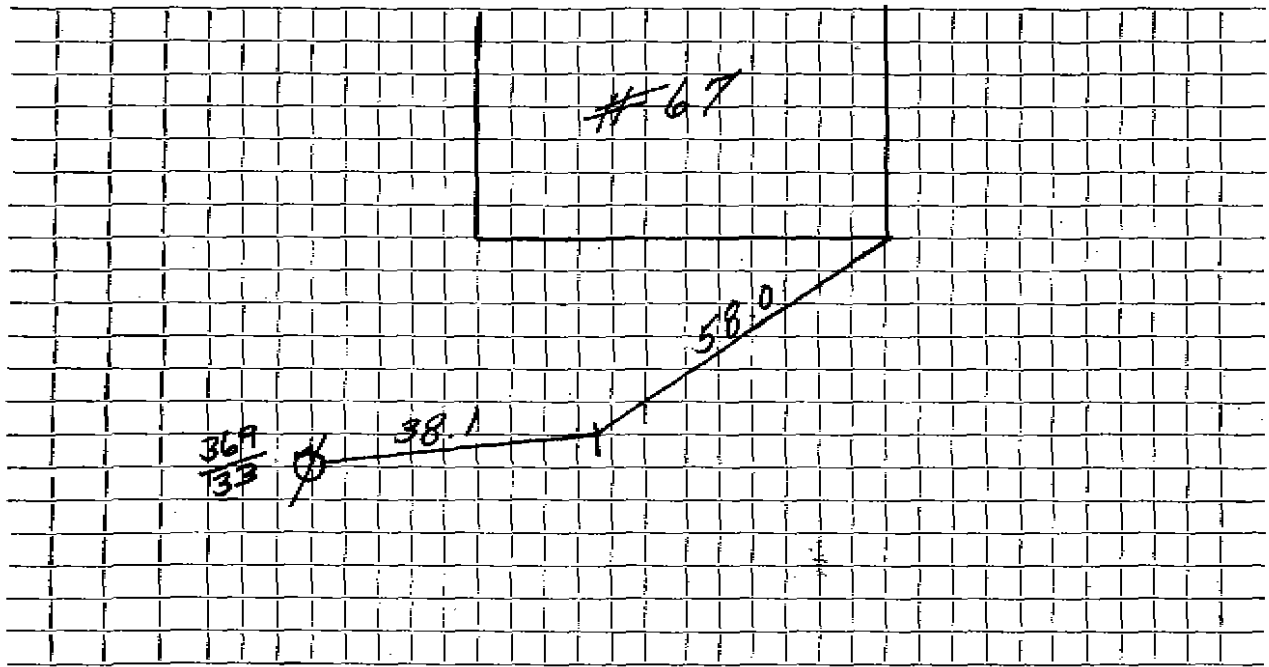

Connection made in BASKIN RD. Street. Work completed

Remarks:
.....
.....