

WATER SERVICE RECORD

2698

Name Richard Magnanti

Service No. 264

Address 7 Baskin Road

Location Lot 22

Repair-Renewal-New Service


Comm. 3-3-58

Date	Material	Amount	Total	Date	Material	Amount
12/27/57	Labor	3 52		11-15-57	Deposit	\$ 50 00
	10% overhead	35	3 87	3-3-58	Refund	13 73
	66' - 3/4" Copper tubing @ .37		24 42		NON CHARGE	\$ 36 27
	1 - 3/4" Cx 1/2 I.W.H. Stop & Waste		4 96	9/27/57	Labor	4 64
	1 hr. Trucking		75	17' - 3/4" Copper tubing		6 38
	1 - 3/4" C. Union (3 part)		2 27	1 - 3/4" G. Corp Cock		4 64
			36 27	1 - 3/4" G. Gurb Cock		5 94
				1 Box & Rod		4 62
						26 22

DATE 3/8/59

TOWN OF LEXINGTON — BOARD OF PUBLIC WORKS  
WATER DIVISION

Sketch of Service Here

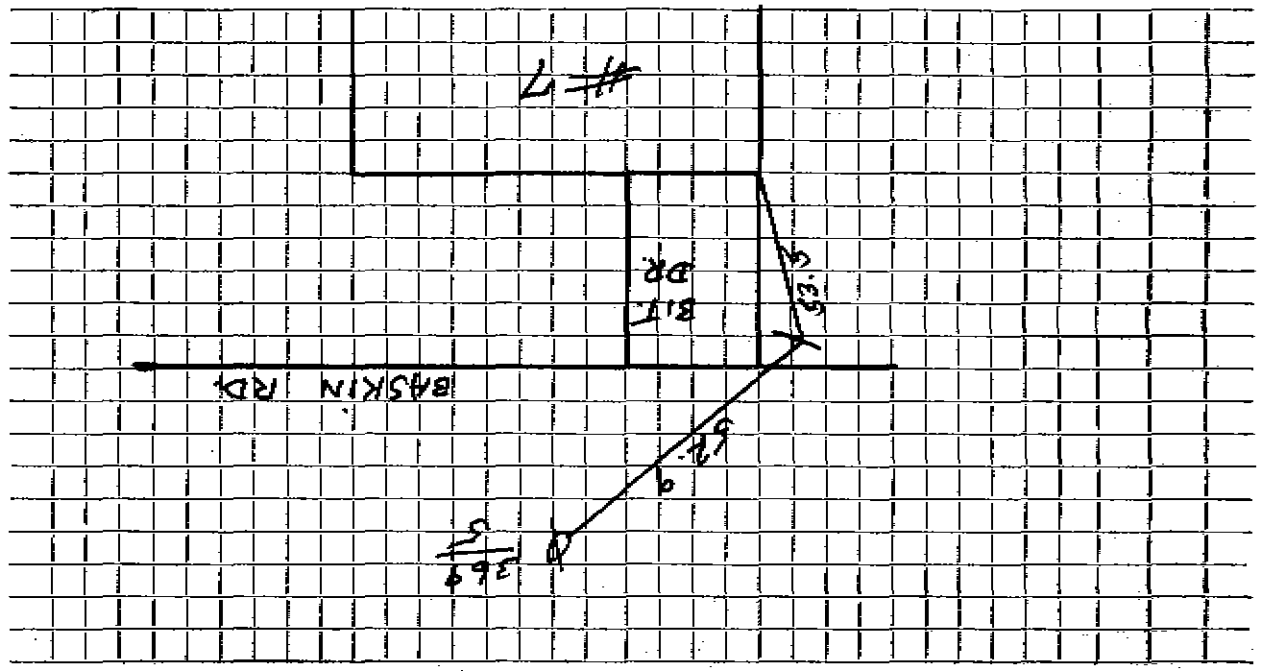

Connection made in BASKIN RD Street. Work completed

Remarks: