

WATER SERVICE RECORD

#4286

Name Frank Dea

Service No. 292

Address 9 Baskin Road

Location Lot 21

Repair—Renewal—New Service


Comm. 3-3-58

Date	Material	Amount	Total	Date	Amount	
12/31/57	Labor	3 52		12-26-57	Deposit	\$ 50 00
	10% overhead	35	3 87	3-3-58	Refund	24 51
	43' - 3/4" Copper tubing @ .37		15 91		NON CHARGE	\$ 25 49
	1 - 3/4" Cr $\frac{1}{2}$ I.W.H. Stop & Waste		4 96	9/27/57	Labor	4 64
	1 hr. trucking		75	12' 3/4"	Copper tubing	4 50
			25 49	1 3/4"	C. Corp Cock	4 64
				1 3/4"	C Curb Cock	5 94
				1	Box & Rod	4 62
						24 34

DATE 3/8/59

TOWN OF LEXINGTON — BOARD OF PUBLIC WORKS
WATER DIVISION

Sketch of Service Here

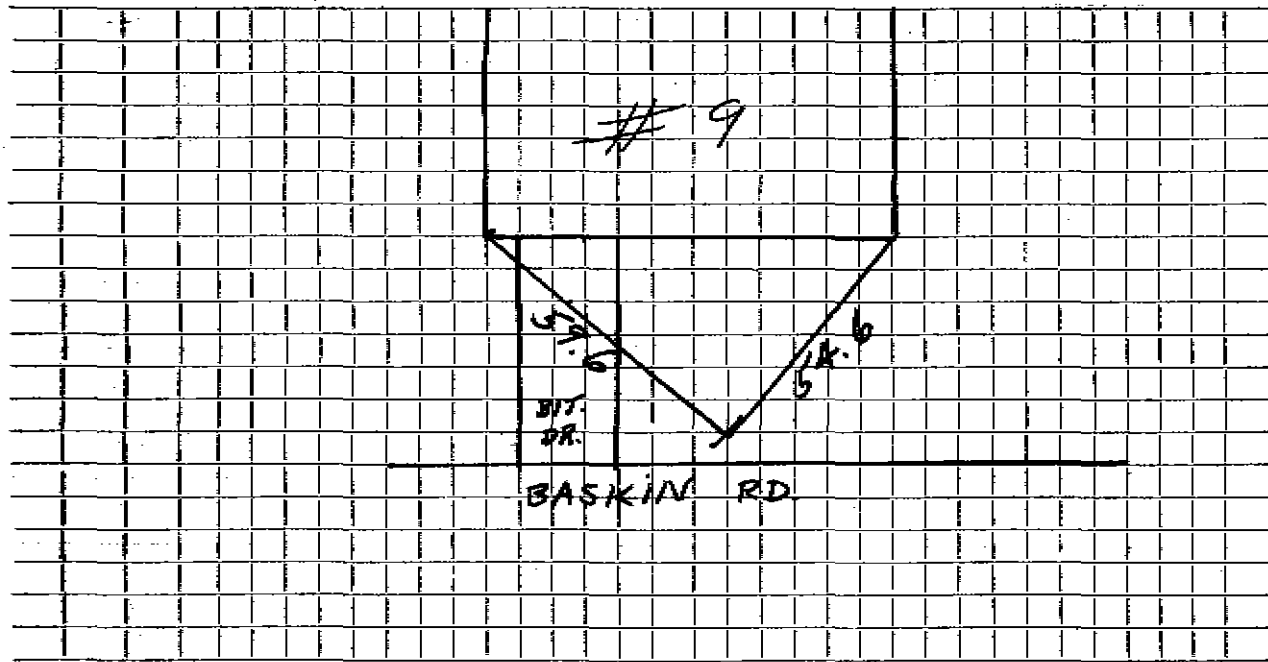

Connection made in BASKIN RD. Street. Work completed

Remarks:
.....
.....