

WATER SERVICE RECORD

2620

Name Macland, Inc.

Service No. 149

Address 10 Bates Road

Location Lexington

~~Repair/ Renewal~~ New Service COM. 9/8/52


Date	Material	Amount	Total	Date	Amount
7/18/52	Labor	1 63		7-17-52 Deposited	15 00
	10% overhead	16	1 79	9-8-52 Paid	1 50
	20' - 3/4" copper tubing @ .326	6 52			<u>NON CHARGE</u> 16 50
	1 - 3/4" C x 1/2" I.W.F. stop&w.	4 00		7/18/52 Labor	6 01
	2 - 3/4" C x 3/4" C. unions @ 1.72	3 44		9' - 3/4" copper tubing @ .326	2 93
	1 hr. trucking		75	1 - 3/4" C. corp-cock	4 33
			16 50	1 - 3/4" C x 3/4" C. curb-cock	4 67
	TRENCH DUG BY OWNER			1 box and rod	4 68
	PIPE SUPPLIED AND LAID BY OWNER			1 - 1/2" offset tail piece	50
				1 - 1/2" straight tail piece	50
				1 hr. trucking	75
					<u>24 37</u>

DATE _____

TOWN OF LEXINGTON — BOARD OF PUBLIC WORKS

WATER DIVISION

Sketch of Service Here

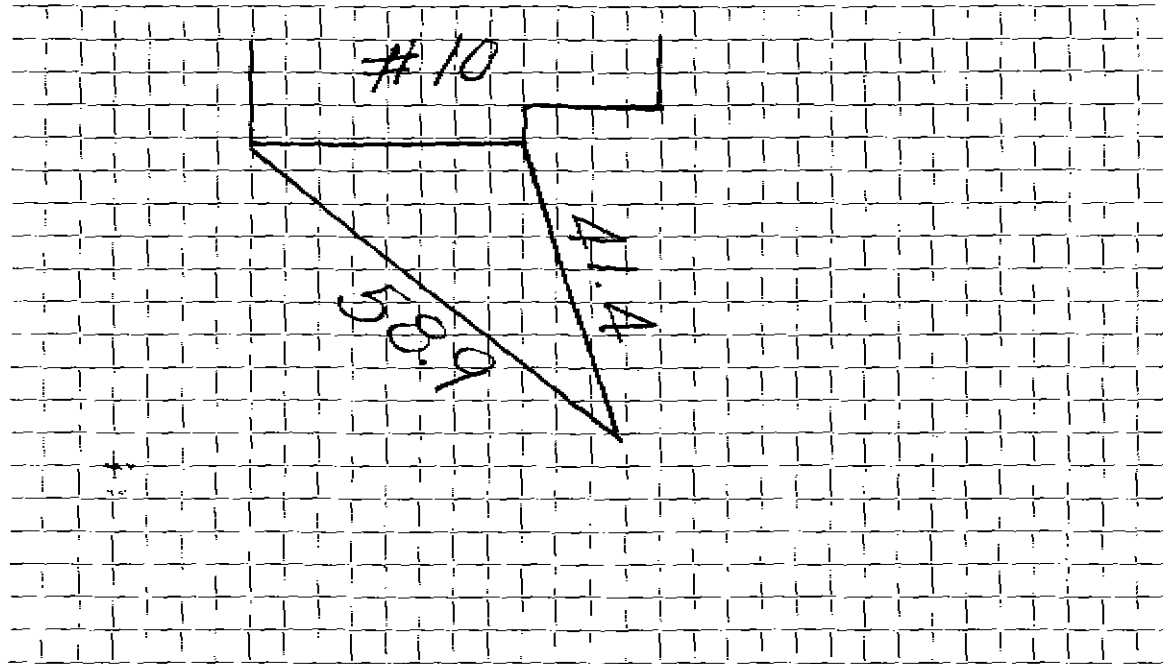

Connection made in Street. Work completed

Remarks:

.....
.....