

WATER SERVICE RECORD

Name

Service No.

Address

11 BATES RD

Location

Repair—Renewal—New Service


Date	Material	Amount	Total	Date	Amount
8-19-02	39' - 1" Copper 1- 3/4" x 1" Adpt 1- Buffalo Box			7-21-52	28' - 3/4" Copper 3/4" curb 3/4" Corp

DATE _____

TOWN OF LEXINGTON — BOARD OF PUBLIC WORKS

WATER DIVISION

Sketch of Service Here

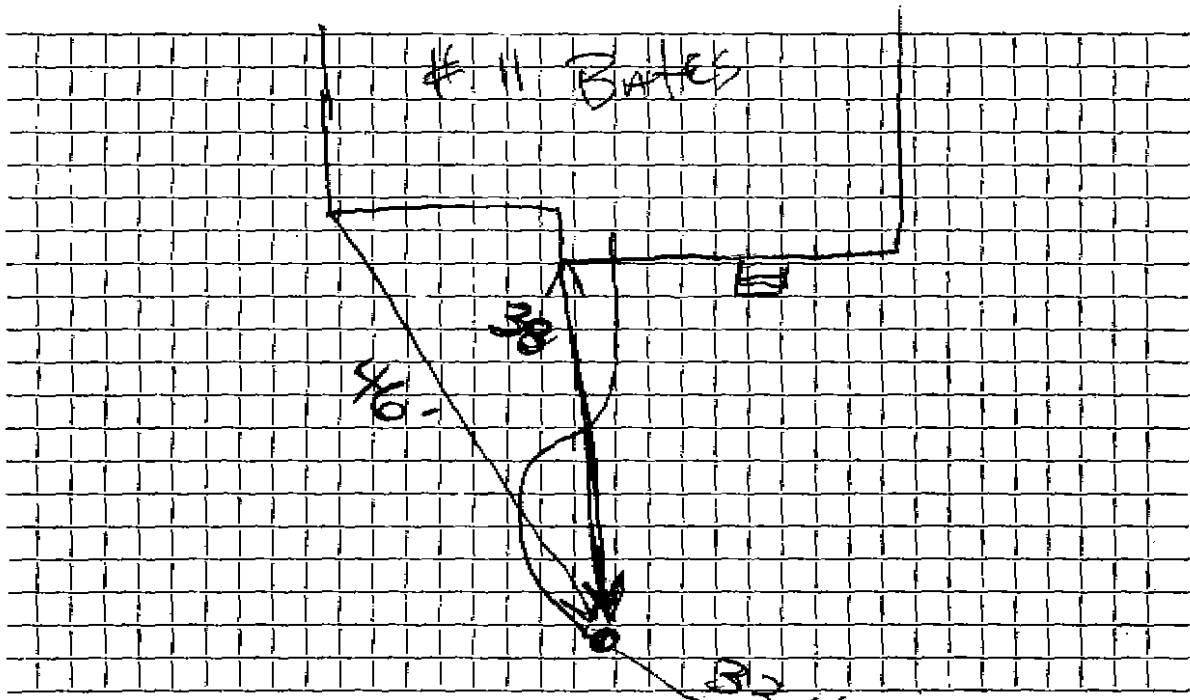

Connection made in Street. Work completed 256 / 10

Remarks:
.....
.....