


DATE 8/12/19

TOWN OF LEXINGTON — BOARD OF PUBLIC WORKS

WATER DIVISION

Sketch of Service Here

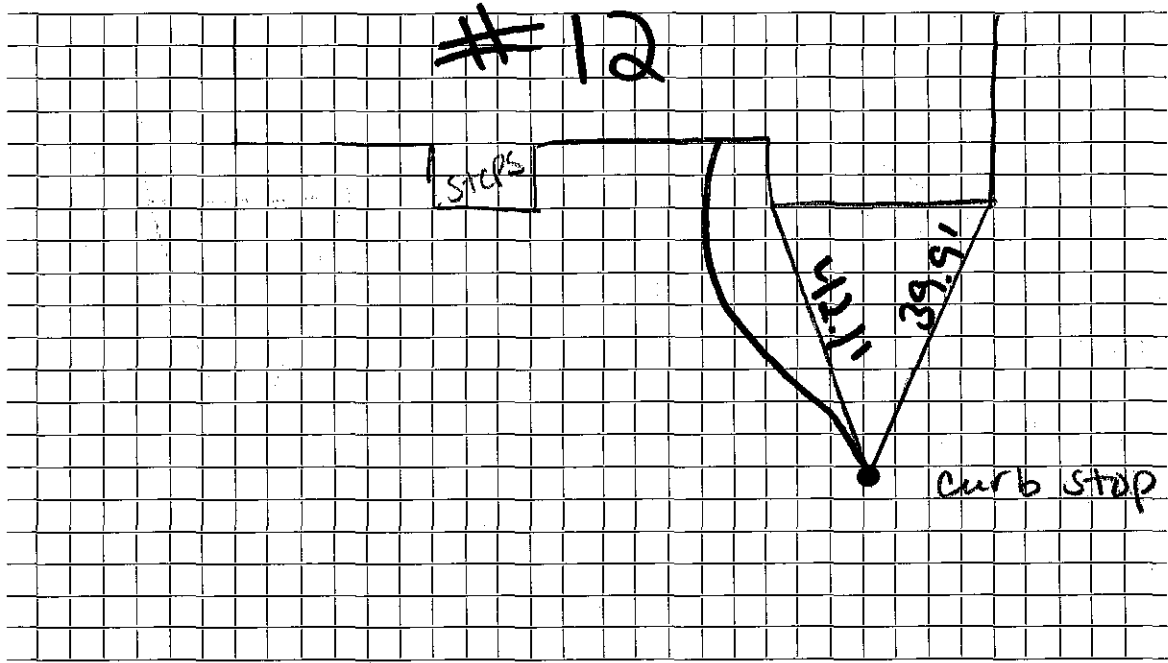

depth @ 5'

Connection made in Bates Rd Street. Work completed

Remarks: