

486

WATER SERVICE RECORD

Name Macland, Inc.

Service No. 149

Address 16 Bates Road

Location Lexington

~~Repair/Reconnect~~ - New Service COM. 9/8/52


Date	Material	Amount	Total	Date	Amount
7/18/52	Labor	1 63		7-17-52 Deposited	15 00
	10% overhead	16	1 79	9-10-52 Refunded	(4) 13
	8' - 3/4" copper tubing@.326	2 61		NON CHARGE	10 57
	1 - 3/4" C x 1/2 I.W.F. stop & waste	4 00	7/18/52 Labor		6 01
	1 - 3/4" C x 3/4" C union 3 pts.	1 72	12' - 3/4" copper tubing@.326		3 91
	1 hr. trucking	75	1 - 3/4" C. corp-cock		4 33
			10 87	1 - 3/4" C x 3/4" C curb-cock	4 67
	TRANCH DUG BY OWNER			1 box and rod	4 68
	PIPE SUPPLIED AND LAID BY OWNER			1 - 1/2 offset tail piece	50
				1 - 1/2 straight tail piece	50
				1 hr. trucking	75
					25 35

DATE _____

TOWN OF LEXINGTON — BOARD OF PUBLIC WORKS

WATER DIVISION

Sketch of Service Here

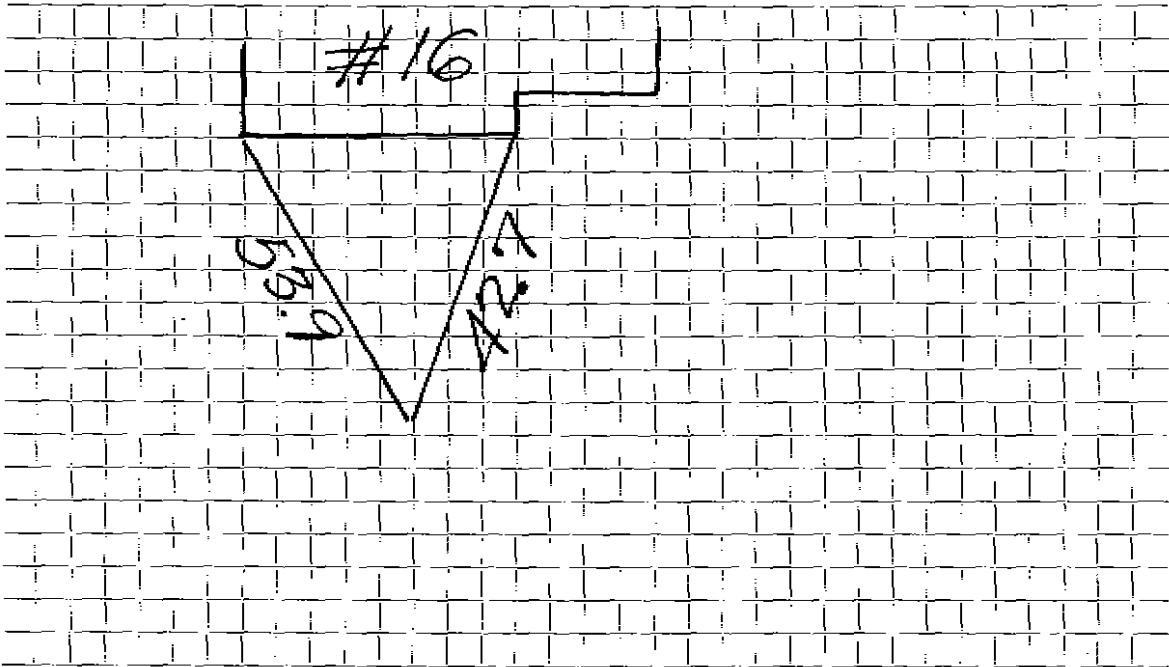

Connection made in Street. Work completed

Remarks:

.....

.....