

WATER SERVICE RECORD

Name Macland, Inc.

Service No. 149

Address 18 Bates Road

#7300

Location Lexington

~~Repair~~ ~~Renewal~~ New Service

Com. 9-22-52


| Date | Material | Amount | Total | Date | Amount |
|--------|---------------------------------------|--------|--------|----------------------------------|---------------------------------|
| 9/8/52 | Labor | 1 63 | | 7-17-52 | Deposited 15 00 |
| | 10% overhead | 16 | 1 79 | 9-24-52 | Paid 12 17 |
| | 55' - 3/4" copper tubing @ .3439 | 18 91 | | | <u>NON CHARGE</u> 27 17 |
| | 1 - 3/4" C x 1/2" I.W.E. stop & waste | 4 00 | 9/8/52 | Labor | 3 07 |
| | 1 - 3/4" C x 3/4" C. union 3 pts. | 1 72 | | 55' - 3/4" copper tubing @ .3439 | 18 91 |
| | 1 hr. trucking | 75 | | 1 - 3/4" C. corp-cock | 4 33 |
| | | | 27 17 | 1 - 3/4" C x 3/4" C. curb-cock | 4 67 |
| | TRENCH DUG BY OWNER | | | 1 - box and rod | 3 90 |
| | PIPE SUPPLIED AND LAID BY OWNER | | | 1 - 1/2" offset tail piece | 50 |
| | | | | 1 - 1/2" straight tail piece | 50 |
| | | | | 1 - hr. trucking | 75 |
| | | | | | 36 63 |
| | | | | 7-30-75 | Repair Water Service W.O. #3576 |
| | | | | | Labor \$ 9 12 |
| | | | | 6' | 3/4" Copper Pipe @ .101 6 06 |
| | | | | 2 | 3 part Unions @ .387 7 74 |
| | | | | 6' | solder @ .14 84 |
| | | | | | \$ 23.76 |

DATE _____

TOWN OF LEXINGTON — BOARD OF PUBLIC WORKS

WATER DIVISION

Sketch of Service Here

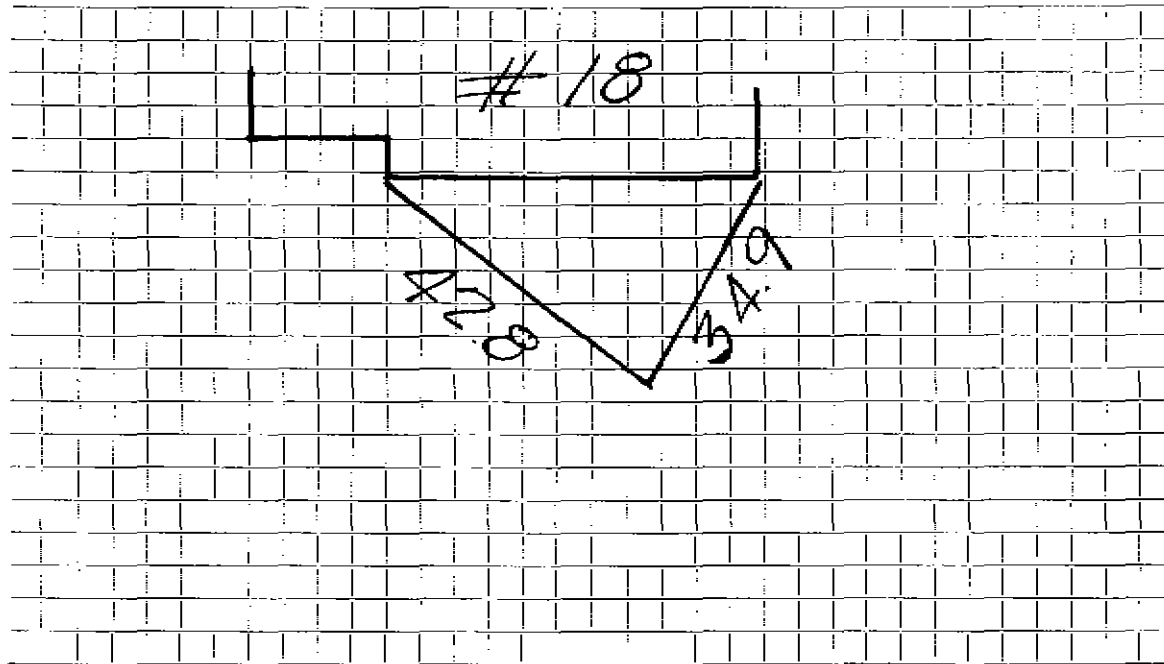

Connection made in Street. Work completed

Remarks:

.....

.....