


DATE _____

TOWN OF LEXINGTON — BOARD OF PUBLIC WORKS
WATER DIVISION

Sketch of Service Here

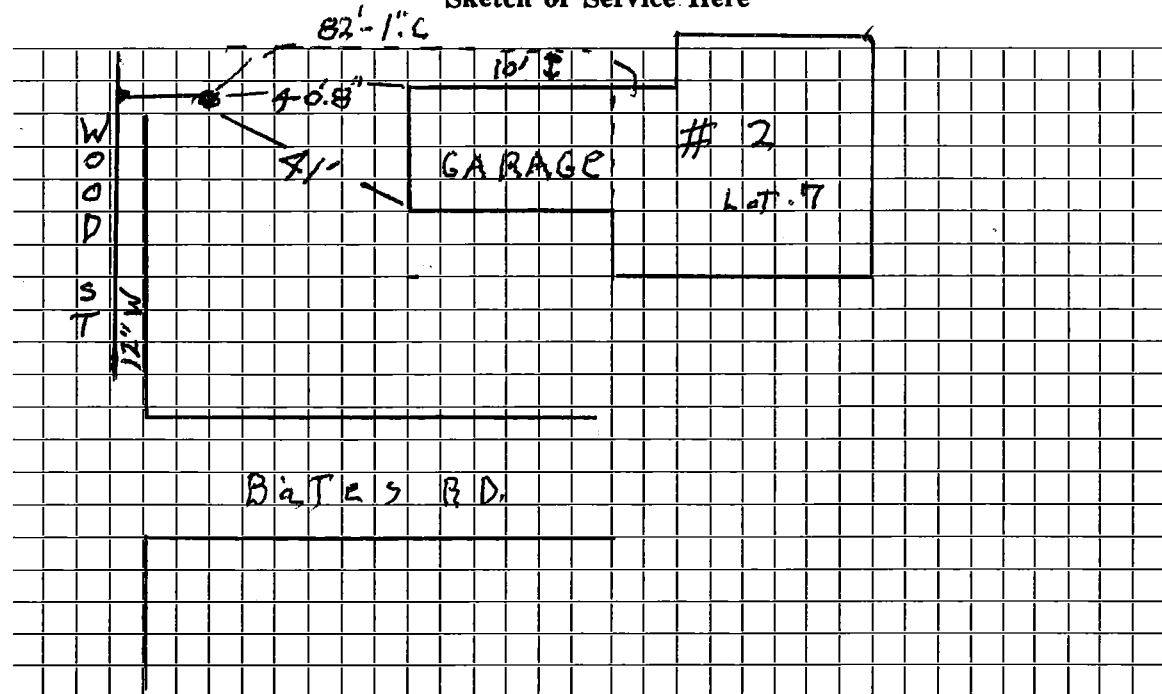

Connection made in Street. Work completed

Remarks: 237 Wood St. Number changed now - 2 Bates Rd - 2011

.....
.....