

WATER SERVICE RECORD

Name Macland, Inc.

Service No. 149

Address 4 Bates Road

Location Lexington

~~Repair/Extend~~ New Service COM. 9/8/52


Date	Material	Amount	Total	Date	
7/18/52	Labor	1 63		2-17-52	<i>Deposited</i> <i>9-10-52</i> <i>Refunded & credited per</i> <i>Bill due on 10/10/52</i>
	10% overhead	16	1 79	9-10-52	
	10' - 3/4" copper tubing @ .326	3 26			
	1 - 3/4" C x 3/4" I.W.H. step & waste		4 00	7/18/52	Labor
	1 - 3/4" C x 3/4" C. union 3 pts.		1 72		9' - 3/4" copper tubing @ .326
	1 - hr. trucking		75		1 - 3/4" C. corp-cock
			11 52		1 - 3/4" C x 3/4" C. curb-cock
	TRENCH DUG BY OWNER				1 - box end rod
	PIPE SUPPLIED & LAID BY OWNER				1 - 1/2" offset tail piece
					1 - 1/2" straight tail piece
					1 - hr. trucking

DATE _____

TOWN OF LEXINGTON — BOARD OF PUBLIC WORKS

WATER DIVISION

Sketch of Service Here

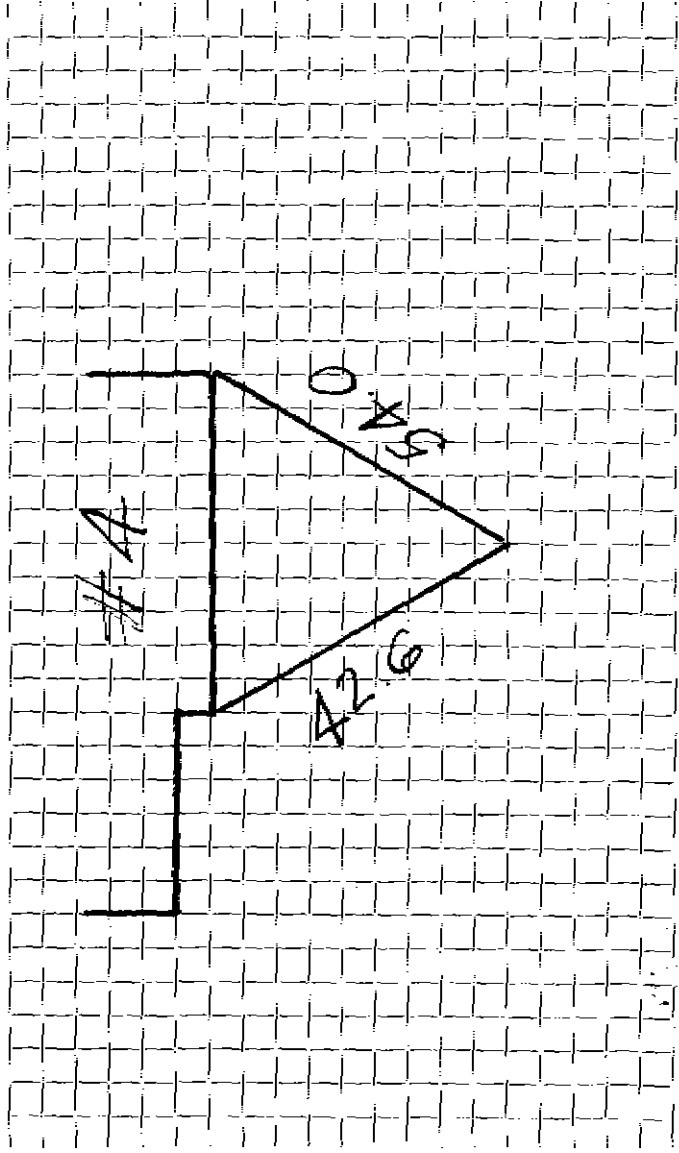

tion made in Street. Work completed

ks: