

WATER SERVICE RECORD

Name MacLend, Inc.

Service No. 149

Address 5 Bates Road

Location Lexington

~~Repair~~ ~~Renewal~~ New Service

Com 9-22-52


Date	Material	Amount	Total	Date	Amount
8/19/52	Labor	1 63		7-17-52 Deposited	15 00
	10% overhead	16	1 79	9-22-52 <i>Refunded</i>	2 47
	9' - 3/4" copper tubing@.3439	3 10		<i>NON CHARGE</i>	1 17
	1 - 3/4" C x 1/2" I.W.H.stop & waste	4 00			11 36
	1 - 3/4" C x 3/4" C. union	1 72		8/19/52 Labor	3 06
	1 hr. trucking		75	28' - 3/4" copper tubing@.3439	9 63
			11 36	1 - 3/4" C. corp-cock	4 33
	TRENCH DUG BY OWNER			1 - 3/4" C x 3/4" C. curb-cock	4 67
	PIPE SUPPLIED AND LAID BY OWNER			1 box and rod	3 90
				1 - 1/2" offset tail piece	50
				1 - 1/2" straight tail piece	50
				1 hr. trucking	75
					<u>27 34</u>

DATE _____

TOWN OF LEXINGTON — BOARD OF PUBLIC WORKS

WATER DIVISION

Sketch of Service Here

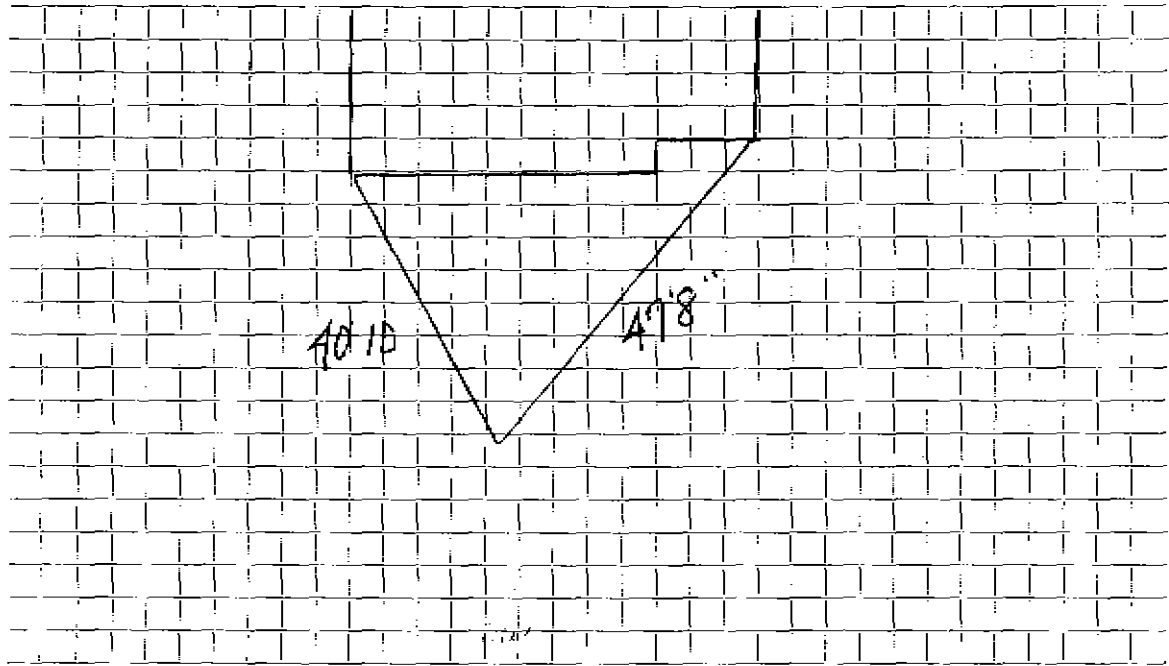

Connection made in Street. Work completed

Remarks:
.....
.....