


TOWN OF LEXINGTON - BOARD OF PUBLIC WORKS  
WATER DIVISION

Date: 5/21

SKETCH OF SERVICE HERE

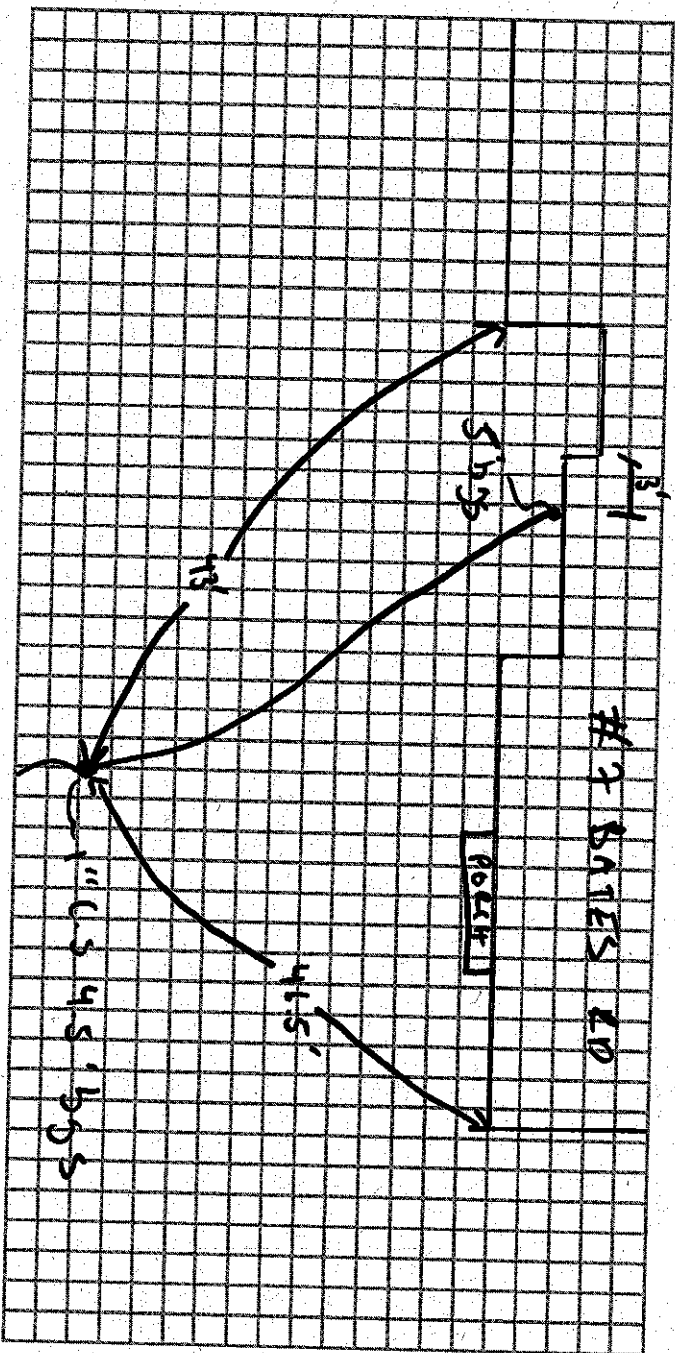

Connection made in:

**BATES**

Remarks:

Street:

Work completed:

Address 7 BATES ROAD

Location

Repair Renewal - New Service

Date	Material	Amount	Total	Date		A
5/21	1" C. Stop &					
	Bl. Box					
	1" Type K copper					

WATER SERVICE RECORD

Name Macland, Inc.

Service No. 149

Address 7 Bates Road

*# 998*

Location Lexington

~~Repair~~ New Service

*Call 9-22-52*


Date	Material	Amount	Total	Date	Amount
8/19/52	Labor	1 63		2-17-52	Deposited 15 00
	10% overhead	16	1 79	9-22-52	Refunded 9 months (4) 33
	7' - 3/4" copper tubing @ .3439	2 41			to No #149
	1 - 3/4" C x 1/2" I.W.E. stop & waste	4 00	8/19/52	Labor	3 06
	1 - 3/4" C x 3/4" C. union	1 72		28' - 3/4" copper tubing @ .3439	9 63
	1 hr. trucking	75	10 67	1 - 3/4" C. corp-cock	4 33
				1 - 3/4" C x 3/4" C. curb-cock	4 67
				1 - box and rod	3 90
	FRANCH LUG BY ORDER			1 - 1/2" offset tail piece	50
	PIPE SUPPLIED & LAID BY ORDER			1 - 1/2" straight tail piece	50
				1 - hr. trucking	75
					<u>27 34</u>

DATE \_\_\_\_\_

TOWN OF LEXINGTON — BOARD OF PUBLIC WORKS

**WATER DIVISION**

Sketch of Service Here

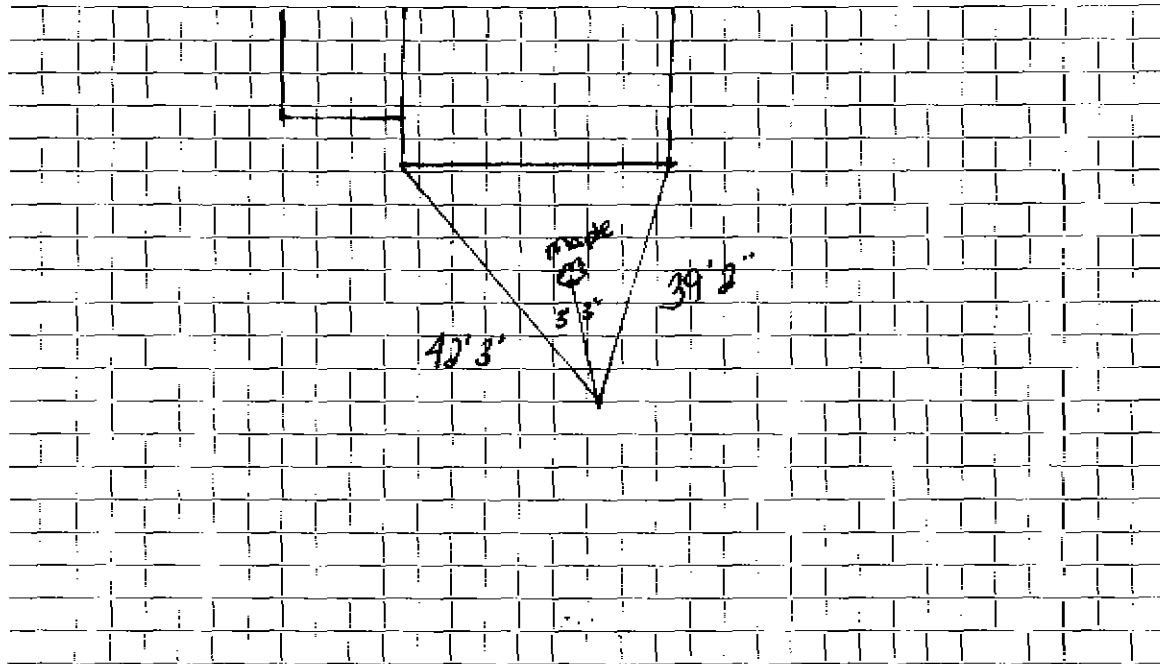

Connection made in ..... Street.                      Work completed .....

Remarks: .....

.....  
.....