


DATE _____

TOWN OF LEXINGTON — BOARD OF PUBLIC WORKS
WATER DIVISION

Sketch of Service Here

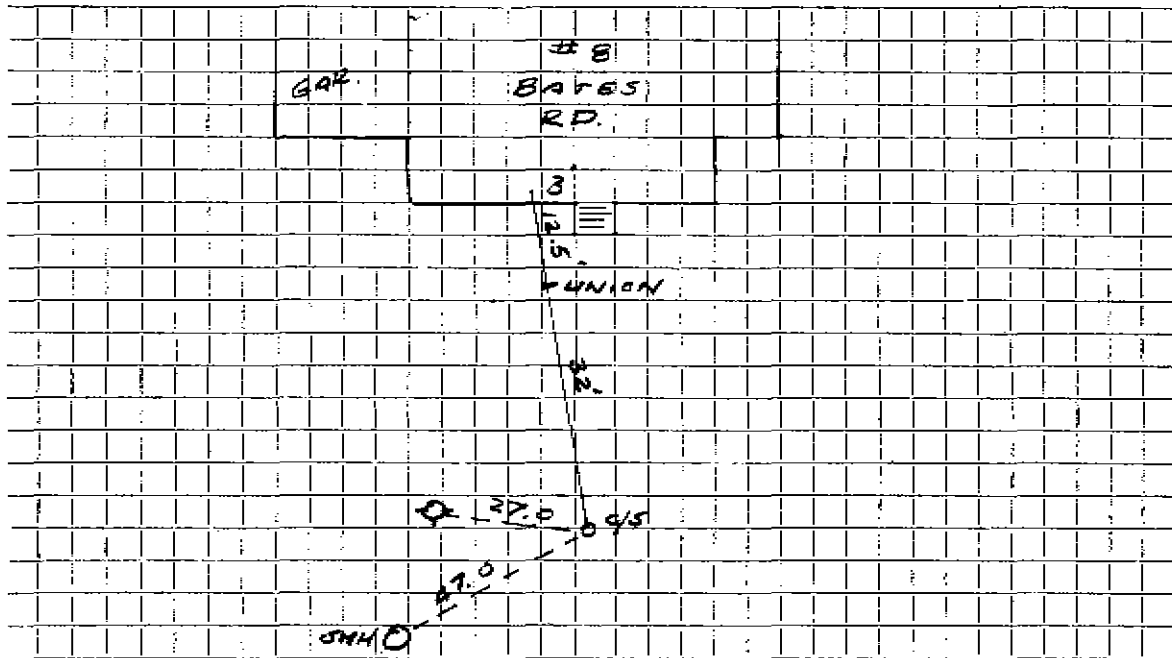

Connection made in BATES RD. Street. Work completed

Remarks: OLD USE REMOVED - USE NEW TIES