

475

WATER SERVICE RECORD

Name Macland, Inc.

Service No. 149

Address 9 Bates Road

Location Lexington

Repair ~~Renewal~~ New Service

Call 9-22-52


Date	Material	Amount	Total	Date	Material	Amount
8/19/52	Labor	1 63		7-17-52	Deposited	15 00
	10% overhead	16	1 79	9-22-52	Refunded & credited	8 46
	1 - 3/4" C x 1/2 I.W.H. stop & waste	4 00			26 2-1/2" C. #149 (17.50)	1 54
	1 - 3/4 hour trucking		75		<u>NON CHARGE</u>	
			6 54	8/19/52	Labor	3 06
	TRENCH DUG BY OWNER				28' - 3/4" copper tubing @ .3439	9 63
	PIPE SUPPLIED AND LAID BY OWNER				1 - 3/4" C. corp-cock	4 33
					1 - 3/4" C x 3/4" C. curb-cock	4 67
					1 - box and rod	3 90
					1 - 1/2 offset tail piece	50
					1 - 1/2 straight tail piece	50
					1 - hr. trucking	75
						<u>27 34</u>

DATE _____

TOWN OF LEXINGTON — BOARD OF PUBLIC WORKS

WATER DIVISION

Sketch of Service Here

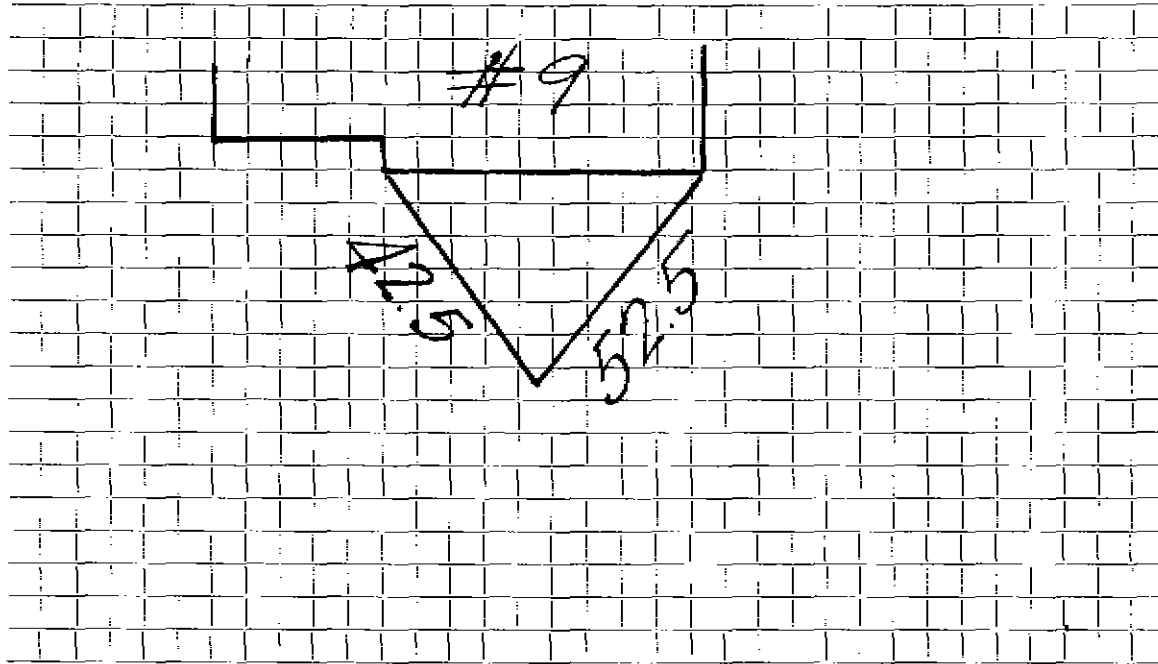

Connection made in Street. Work completed

Remarks:

.....

.....