

WATER SERVICE RECORD

Name DeVries Const. Co., Inc.

Service No. 136

Address 10 Battle Green Rd.

4997

Location

Report ~~XXXXXX~~ - New Service

Com. 8/11/53


Date	Material	Amount	Total	Date	Amount
6/30/53	Labor	1 75		6-10-53	20 00
	10% overhead	18	1 93	8-24-53	(2 28)
	43' - 3/4" copper tubing @ .3629		15 60		22 28
	1 - 3/4" C x 1/2 I.W.H. stop & waste		4 00		
	1 hr. trucking		75	6/30/53	Labor 3 86
			22 28		15' - 3/4" copper tubing @ .3629 5 44
	TRENCH DUG BY OWNER				1 - 3/4" C. corp-cock 4 33
					1 - 3/4" C x 3/4" C. curb-cock 4 67
					1 box and rod 3 90
					1 - 1/2 straight tail piece 50
					1 - 1/2 offset tail piece 50
					1 hr. trucking 75
					23 95
					bill sent 8-11-53

DATE _____

TOWN OF LEXINGTON — BOARD OF PUBLIC WORKS

WATER DIVISION

Sketch of Service Here

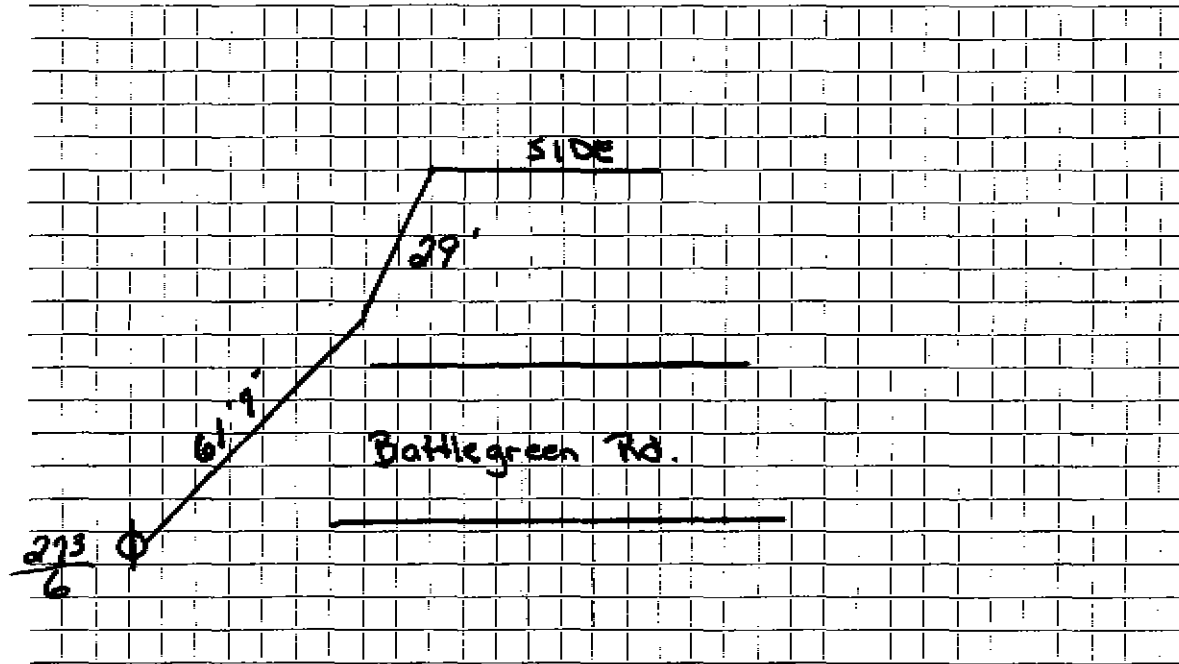

Connection made in Street. Work completed

Remarks:
.....
.....