

WATER SERVICE RECORD

Name DeVries Const. Co., Inc.

Service No. 137

Address 11 Battle Green Road

#3161

Location

~~REPAIR & REPAIR~~ - New Service

Com. 8/10/53


Date	Material	Amount	Total	Date	Amount
7/10/53	Labor	1 75		6-10-53	20 00
	10% overhead	18	1 93	8-24-53	(9 37)
	46' - 3/4" copper tubing@.3629		16 69		NON CHARGE
	1 -3/4"C x 1/2 I.W.H. stop&waste		4 00	7/10/53	Labor
	1 hr. trucking		75		26' - 3/4" copper tubing@.3629
			23 37		1 -3/4" C.corb-cock
	TRENCH DUG BY OWNER				1 -3/4"C x 3/4"C.curb-cock
					1 box and rod
					1 -1/2" straight tail pc.
					1 -1/2" offset tail pc.
					1 hr. trucking
					Repair
				7/31/57	2 88 UNIONS
					1 1/4" Curb Cock
					5' 3/4" COPPER
					33 27

TOWN OF LEXINGTON — BOARD OF PUBLIC WORKS

WATER DIVISION

DATE \_\_\_\_\_

Sketch of Service Here

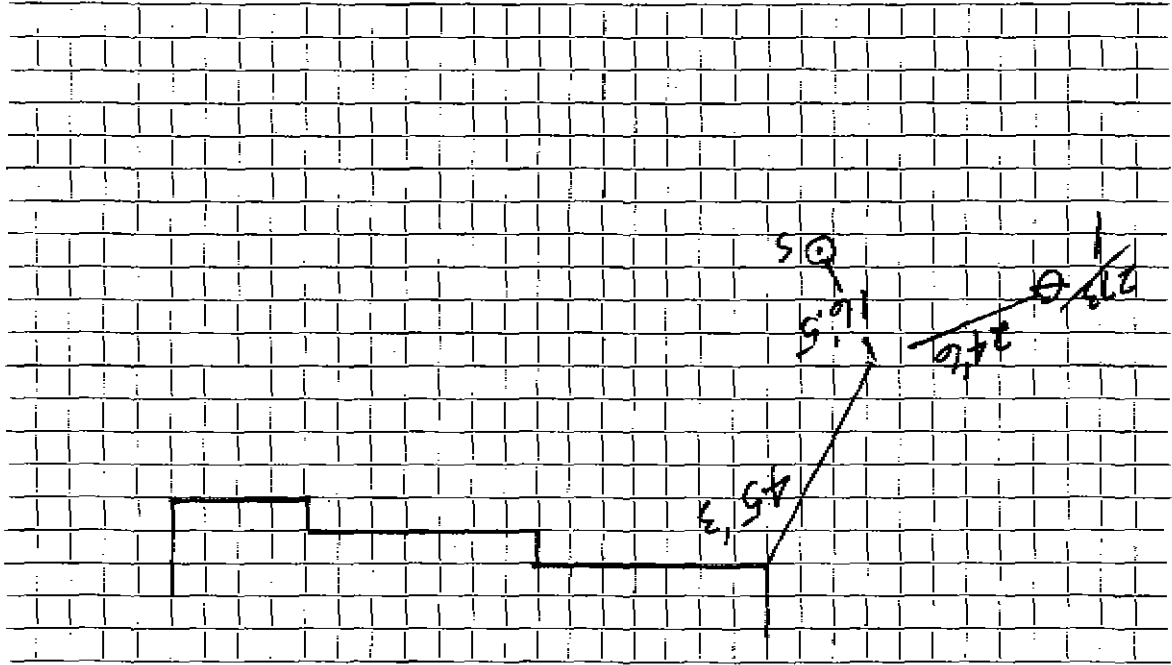

Street: \_\_\_\_\_  
Work completed \_\_\_\_\_

Connection made in \_\_\_\_\_

Remarks: \_\_\_\_\_  
\_\_\_\_\_  
\_\_\_\_\_  
\_\_\_\_\_