

WATER SERVICE RECORD

Name DeVries Const. Co., Inc.

Service No. 138

Address 15 Battle Green Road

Location

~~Repair~~ ~~Renewal~~ New Service

*Com. 8/10/53*


Date	Material	Amount	Total	Date	Amount
7/9/53	Labor	1 75		6-10-53	Deposited 20 00
	10% overhead	18	1 93	6-24-53	Paid (17 37)
	46' - 3/4" copper tubing@.3629-16	69			<u>NON CHARGE</u> 219 37
	1 -3/4"C x 1/2 I.W.H.stop&waste	4 00	4 00	7/9/53	Labor 12 74
	1 hr. trucking		75	24' - 3/4" copper tubing@.3629	8 71
			23 37	1 -3/4" C.corb-cock	4 33
	TRENCH DUG BY OWNER.			1 -3/4"C x 3/4"C.curb-cock	4 67
				1 box and rod	3 90
				1 -1/2"straight tail piece	50
				1 -1/2"offset tail piece	50
				1 hr. trucking	75
				Repair	36 10
				8/8/57 1 3/4 Curb	
				2 88 Unions	
				5 3/4 COPPER	

DATE \_\_\_\_\_

TOWN OF LEXINGTON — BOARD OF PUBLIC WORKS

WATER DIVISION

Sketch of Service Here

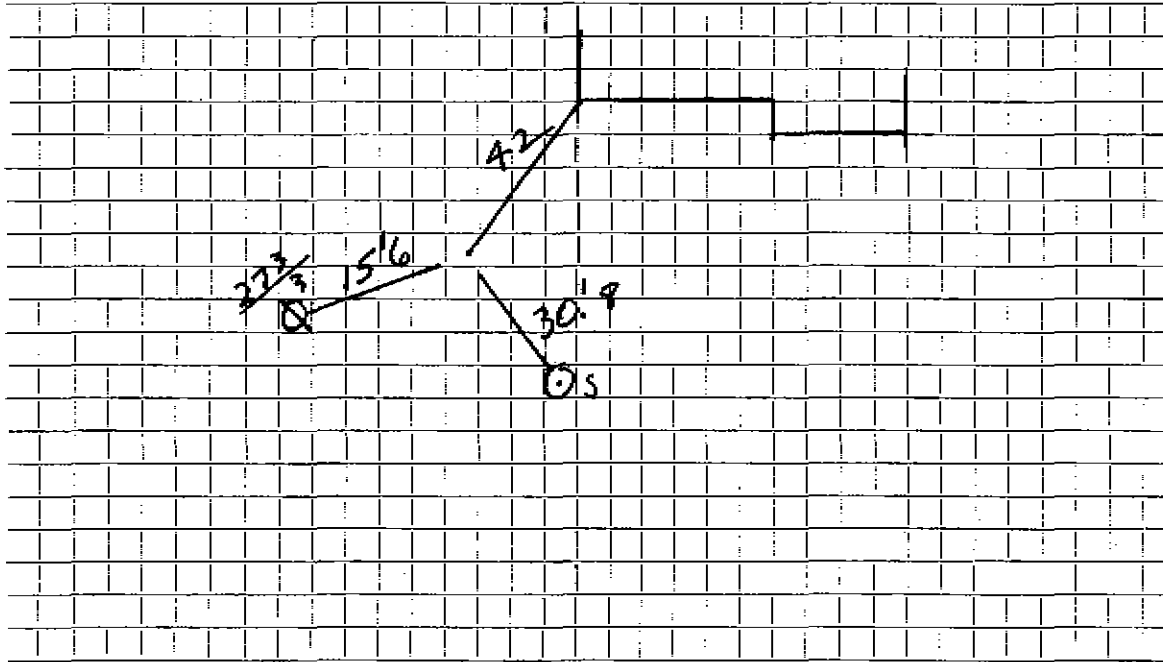

Connection made in ..... Street. Work completed .....

Remarks: .....

.....

.....