

WATER SERVICE RECORD

Name DeVries Const. Co., Inc.

Service No. 139

Address 16 Battle Green Road

Location

~~Repair~~ ~~REWORK~~ - New Service

*Com. 8-10-53*


Date	Material	Amount	Total	Date	Amount
7/9/53	Labor	1 75		6-10-53	Deposited 20 00
	10% overhead	18	1 93	8-10-53	* Refunded (1 34)
	33' - 3/4" copper tubing @ .3629	11 98	11 98		<u>NON CHARGE</u> 18 66
	1 - 3/4" C x 1/2 I.W.H. stop & waste	4 00	4 00	7/9/53	Labor 12 73
	1 hr. trucking		75	20' - 3/4" copper tubing @ .3629	7 26
			18 66	1 - 3/4" C. corp-cock	4 33
	TRENCH DUG BY OWNER			1 - 3/4" C x 3/4" C. curb-cock	4 67
				1 box and rod	3 90
				1 - 1/2 straight tail pc.	50
				1 - 1/2 offset tail pc.	50
				1 hr. trucking	75
					<u>34 64</u>
				* this refund made payable Tow. to apply on n.H.C. # 1414	
				8/26/57	REPAIR
					4' 3/4 Copper
					1 3/4 Union
					1 3/4 Curb Cock

DATE \_\_\_\_\_

TOWN OF LEXINGTON — BOARD OF PUBLIC WORKS

**WATER DIVISION**

Sketch of Service Here

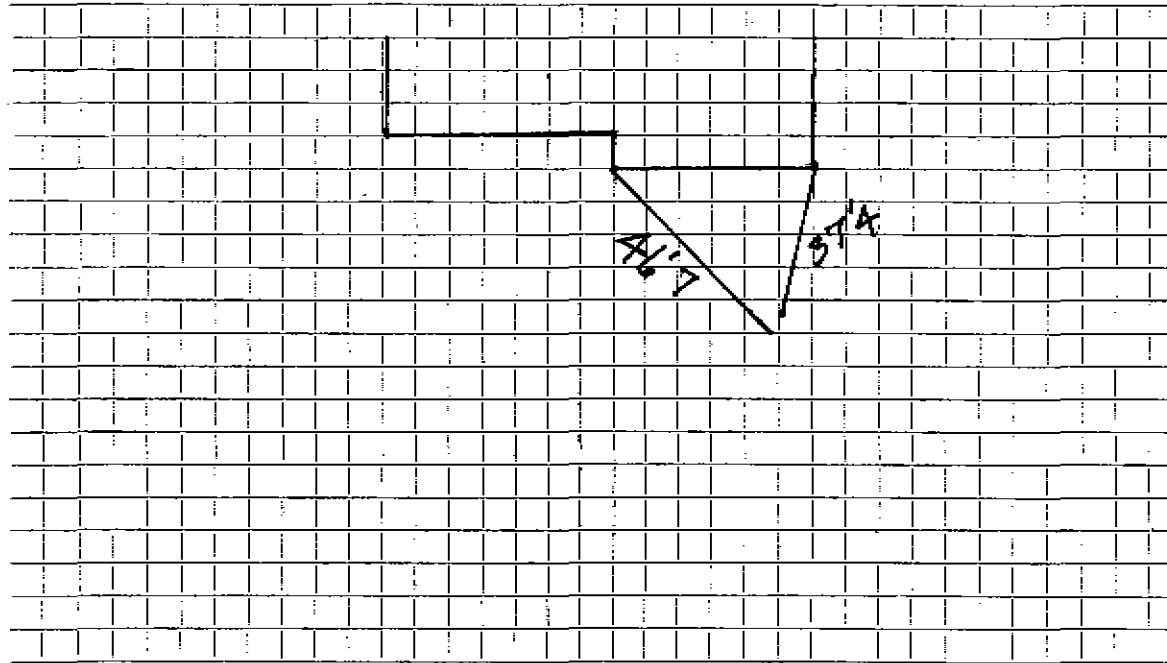

Connection made in ..... Street. Work completed .....

Remarks: .....  
.....  
.....