

WATER SERVICE RECORD

Name DeVries Const. Co., Inc.

Service No. 140

Address 17 Battle Green Road

3897, 3898

Location

~~REPAIR~~ ~~RENEWAL~~ New Service

Com. 8-10-53


Date	Material	Amount	Total	Date	Amount
7/10/53	Labor	1 75		6-10-53	Deposited 20 00
	10% overhead	18	1 93	8-24-53	Paid (3 37)
	46' - 3/4" copper tubing @.3629	16 69			<u>NON CHARGE</u> 23 37
	1 - 3/4" C x 1/2 I.W.F. stop & waste	4 00	7/10/53	Labor	9 19
	1 hr. trucking		75	22' - 3/4" copper tubing @.3629	7 98
			23 37	1 - 3/4" C. corp-cock	4 33
	TRENCH DUG BY OWNER			1 - 3/4" Cx 3/4" C. curb-cock	4 67
				1 box end rod	3 90
				1 - 1/2 straight tail piece	50
				1 - 1/2 offset tail piece	50
				1 hr. trucking	75
					<u>31 82</u>
					<i>bill sent 8-11-53</i>

DATE _____

TOWN OF LEXINGTON — BOARD OF PUBLIC WORKS

WATER DIVISION

Sketch of Service Here

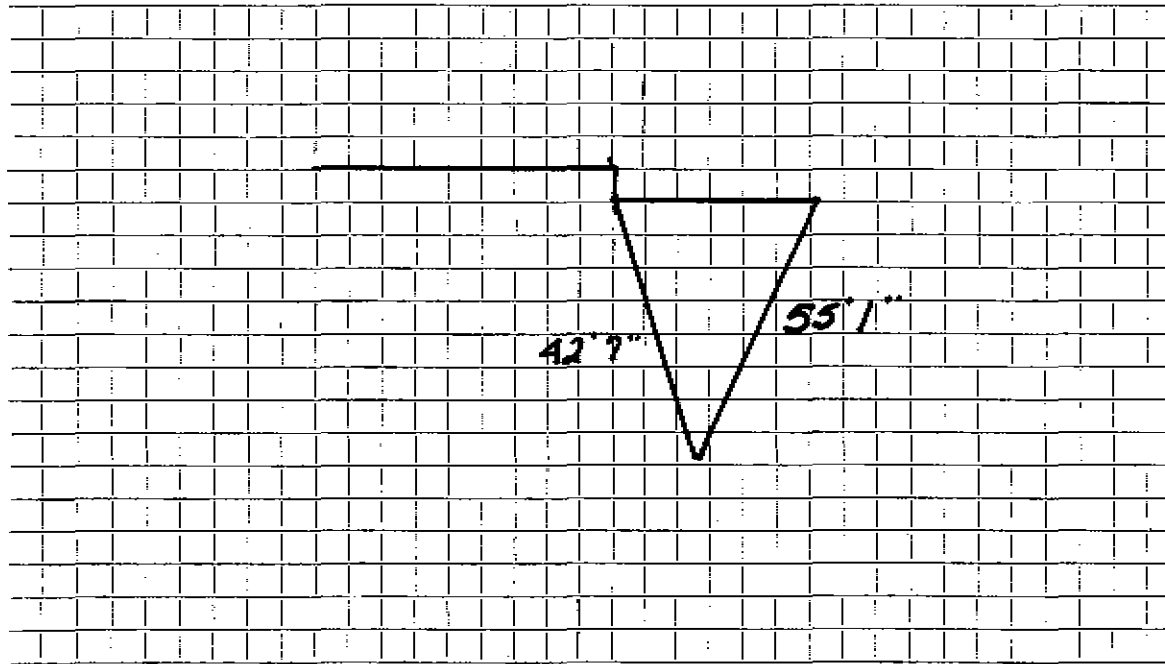

Connection made in Street. Work completed

Remarks:

.....

.....