

WATER SERVICE RECORD

Name DeVries Const. Co., Inc.

Service No. 141

Address 18 Battle Green Rd.

#7066, 7069

Location

~~REPAIR SERVICE~~ - New Service

Com. 8-10-53


Date	Material	Amount	Total	Date	Amount
6/27/53	Labor	1 75		6-10-53	Deposited 20 00
	10% overhead	18	1 93	8-21-53	Paid 1 20
	40' - 3/4" copper tubing @ .3629		14 52		<u>NON CHARGE</u> 21 20
	1 - 3/4" C x 1/2" I.W.H. stop & waste		4 00	6/27/53	Labor 4 49
	1 hr. trucking		75		12' - 3/4" copper tubing @ .3629 4 35
			21 20		1 - 3/4" C. corp-cock 4 33
	TRENCH DUG BY OWNER				1 - 3/4" C x 3/4" C. curb-cock 4 87
					1 - box and rod 3 90
					1 - 1/2" offset ail pc. 50
					1 - 1/2" straight tail pc. 50
					1 hr. trucking 75
					<u>23 49</u>
				9/16/57	REPAIR
					2 88-Union's
					8' 3/4 Copper

DATE _____

TOWN OF LEXINGTON — BOARD OF PUBLIC WORKS

WATER DIVISION

Sketch of Service Here

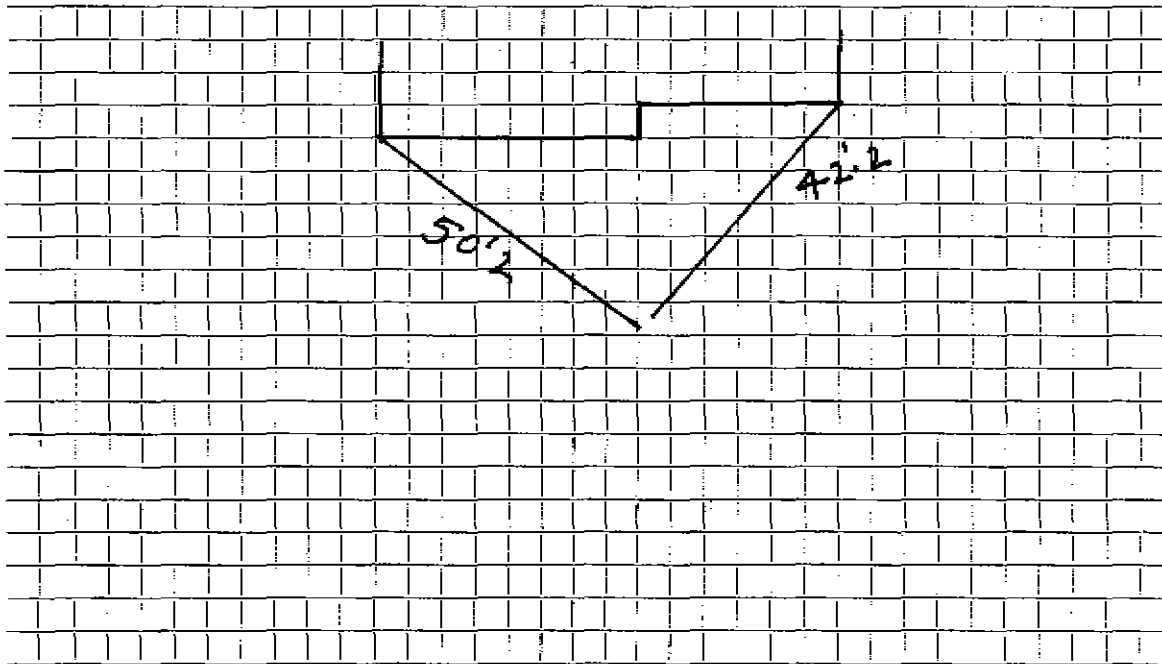

Connection made in Street: Work completed

Remarks:
.....
.....