

WATER SERVICE RECORD

Name DeVries Const. Co. Inc.

Service No. 142

Address 19 Battle Green Road

Location

~~REPAIR WORK~~ - New Service

Com. f-10-53


Date	Material	Amount	Total	Date	Amount
6/27/53	Labor	1 75		6-10-53	Deposited 20 00
	10% overhead	18	1 93	8-24-53	Paid (2 65)
	44' - 3/4" copper tubing@ .3629	.3629	15 97		<u>NON CHARGE</u> 22 65
	1 - 3/4" Cx 1/2 I.W.H. stop & waste		4 00	6/27/53	Labor 4 49
	1 hr. trucking		75		24' - 3/4" copper tubing@ .3629 8 71
			22 65		1 - 3/4" C. corp-cock 4 33
	TRENCH DUG BY OWNER;				1 - 3/4" C x 3/4" C. curb-cock 4 67
					1 box and rod 3 90
					1 - 1/2 offset tail pc. 50
					1 - 1/2 straight tail pc. 50
					1 hr. trucking 75
					<u>27 85</u>
					<i>bill sent f-11-53</i>

DATE _____

TOWN OF LEXINGTON — BOARD OF PUBLIC WORKS

WATER DIVISION

Sketch of Service Here

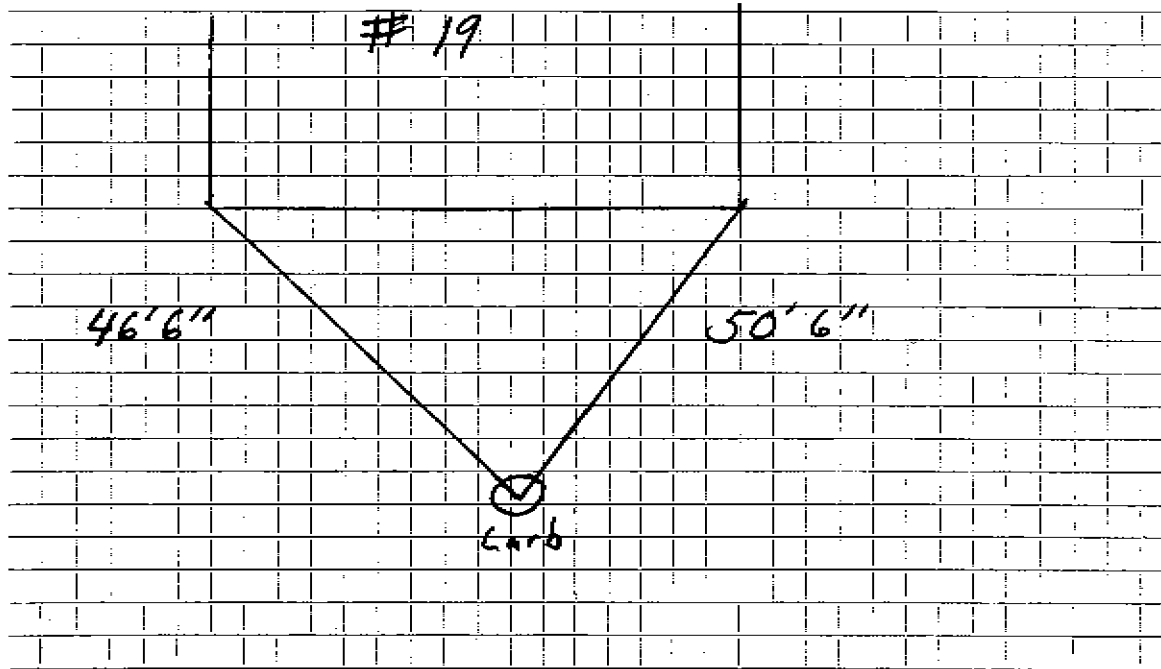

Connection made in Street. Work completed

Remarks:

.....

.....