

WATER SERVICE RECORD

3090

Name DeVries Const. Co., Inc.

Service No. 143

Address 21 Battle Green Rd.

Location

~~Repair~~ ~~Renew~~ - New Service


Com. 8-10-53

Date	Material	Amount	Total	Date	Amount
6/26/53	Labor	1 75		6-10-53 Deposited	20 00
	10% overhead	18	1 93	8-24-53 Paid	47
	38' - 3/4" copper tubing @ .3629	13 79			<u>NON CHARGE</u> 20 47
	1 - 3/4" C x 1/2" I.W.H. stop & waste	4 00		6/26/53 Labor	8 45
	1 hr. trucking		75	24' - 3/4" copper tubing @ .3629	8 71
			20 47	1 - 3/4" C. corp-cock	4 33
	TRENCH DUG BY OWNER			1 - 3/4" C x 3/4" C. curb-cock	4 67
				1 box and rod	3 90
				1 - 1/2" offset tail pc.	50
				1 - 1/2" straight tail pc.	50
				1 hr. trucking	75
					<u>31 81</u>
				<i>bill sent 8-11-53</i>	

TOWN OF LEXINGTON - BOARD OF PUBLIC WORKS

WATER DIVISION

Sketch of Service Here

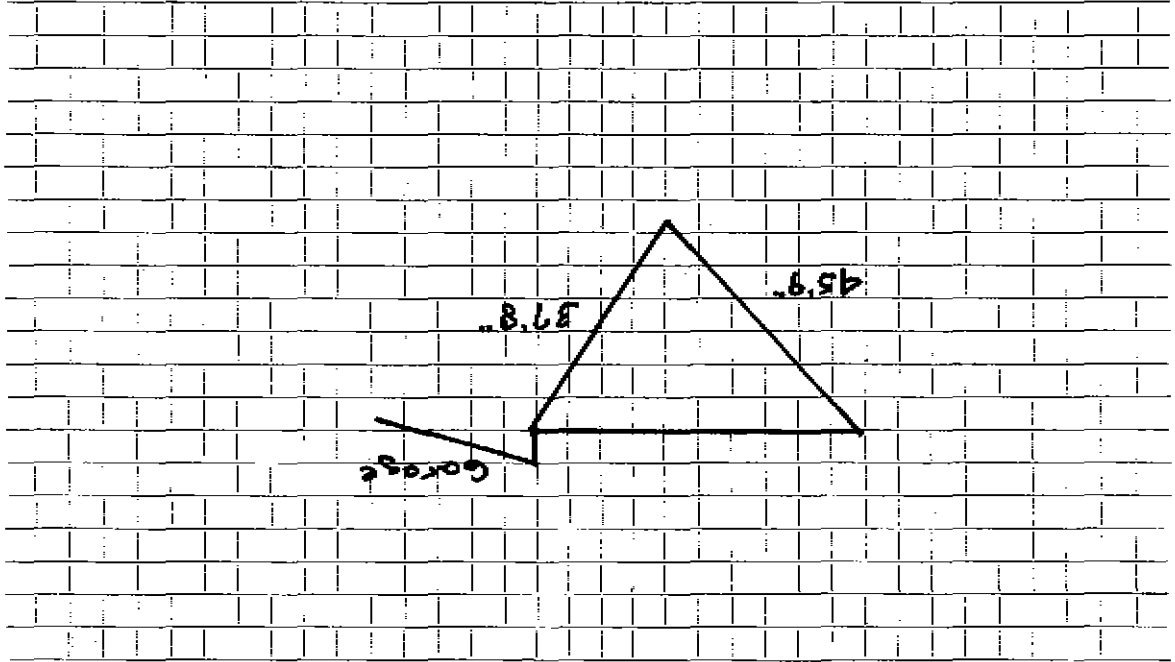

Connection made in Street. Work completed

Remarks: