


DATE _____

TOWN OF LEXINGTON — BOARD OF PUBLIC WORKS

WATER DIVISION

Sketch of Service Here
LOT # 8 HSE # 23

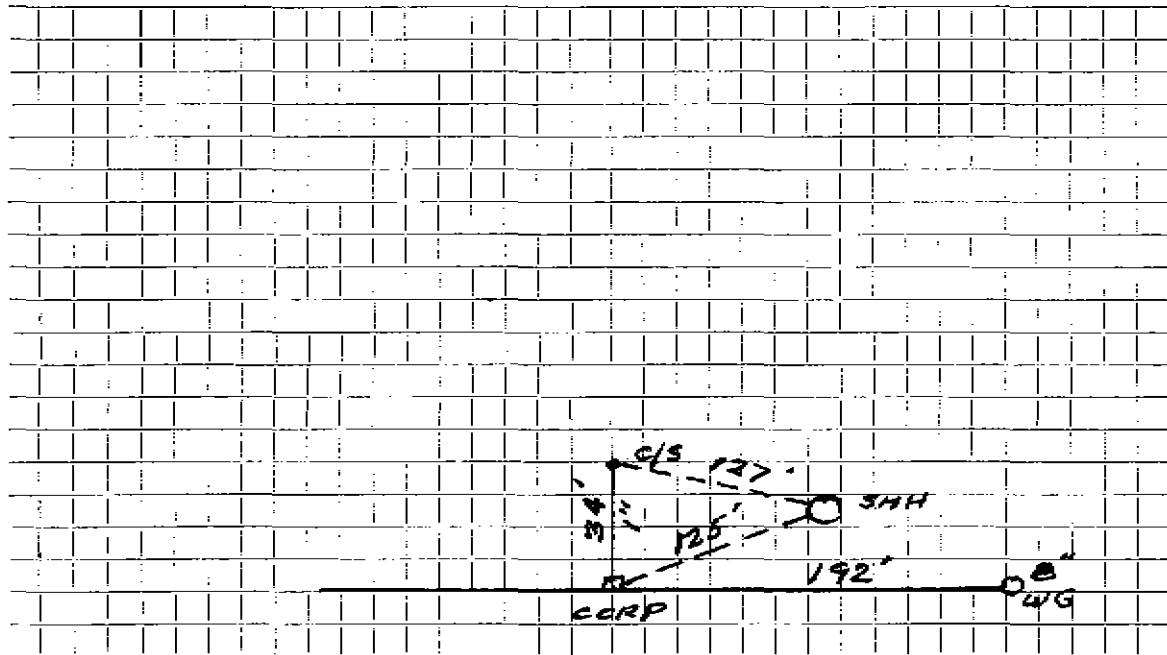

Connection made in BATTLE GREEN LANE Street. Work completed

Remarks:

.....

.....