


DATE _____

TOWN OF LEXINGTON — BOARD OF PUBLIC WORKS

WATER DIVISION

LOT #2 HGE #24

Sketch of Service Here

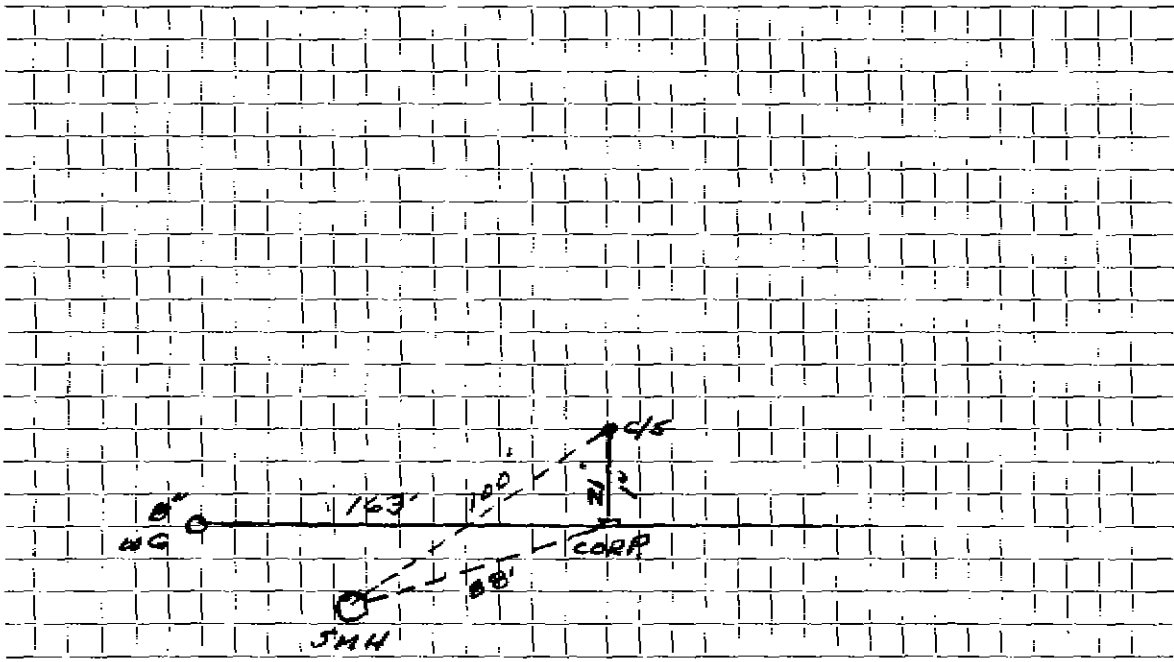

Connection made in BATTLEGREEN RD. Street. Work completed

Remarks:
.....
.....