




DATE \_\_\_\_\_

TOWN OF LEXINGTON — BOARD OF PUBLIC WORKS

**WATER DIVISION**

Sketch of Service Here

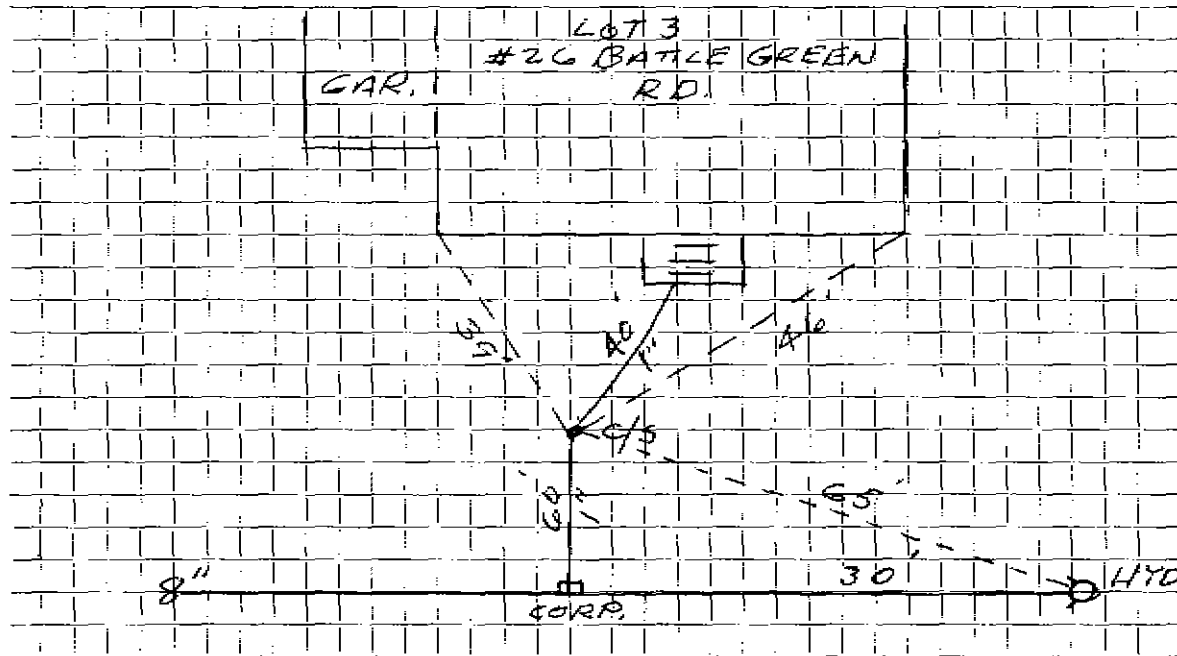

Connection made in BATTLE GREEN RD. Street. Work completed .....

Remarks: .....

.....

.....