


DATE 5/8/18

TOWN OF LEXINGTON — BOARD OF PUBLIC WORKS
WATER DIVISION

Sketch of Service Here

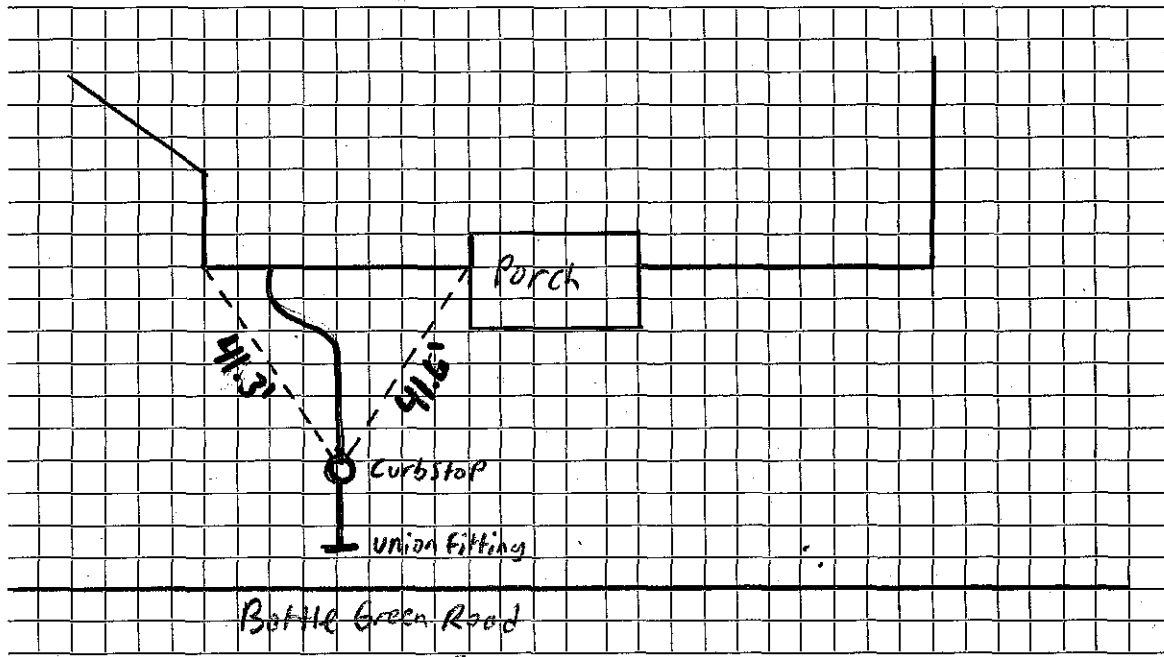

Connection made in Bottle Green ~~Road~~ Street. Work completed

Remarks:
.....
.....