

WATER SERVICE RECORD

Name DeVries Const. Co., Inc.

Service No. 135

Address 9 Battle Green Road

3546

Location

~~Repair~~ - New Service *Com. 8/10/53*

Date	Material	Amount	Total	Date	Amount
6/30/53	Labor	1 75		6-10-53	20 00
	10% overhead	18	1 93	8-10-53	62
	35' -3/4" copper tubing@.3629	12 70			19 38
	1 -3/4" c x 1/2 I.W.H. stop & waste	4 00		6/30/53	3 86
	1 hr. trucking	75		25' - 3/4" copper tubing@.3629	9 07
			19 38	1 -3/4" C. corp-cock	4 33
	TRENCH DUG BY OWNER:			1 -3/4" C x 3/4" curb-cock	4 67
				1 -box and rod	3 90
				1 -1/2 straight tail pc.	50
				1 -1/2 offset tail piece	50
				1 hr. trucking	75
					27 58


Deposited
** Refunded*
NON CHARGE

** 62¢ made payable to Town to apply on w.H.C. #144*

DATE _____

TOWN OF LEXINGTON — BOARD OF PUBLIC WORKS
WATER DIVISION

Sketch of Service Here

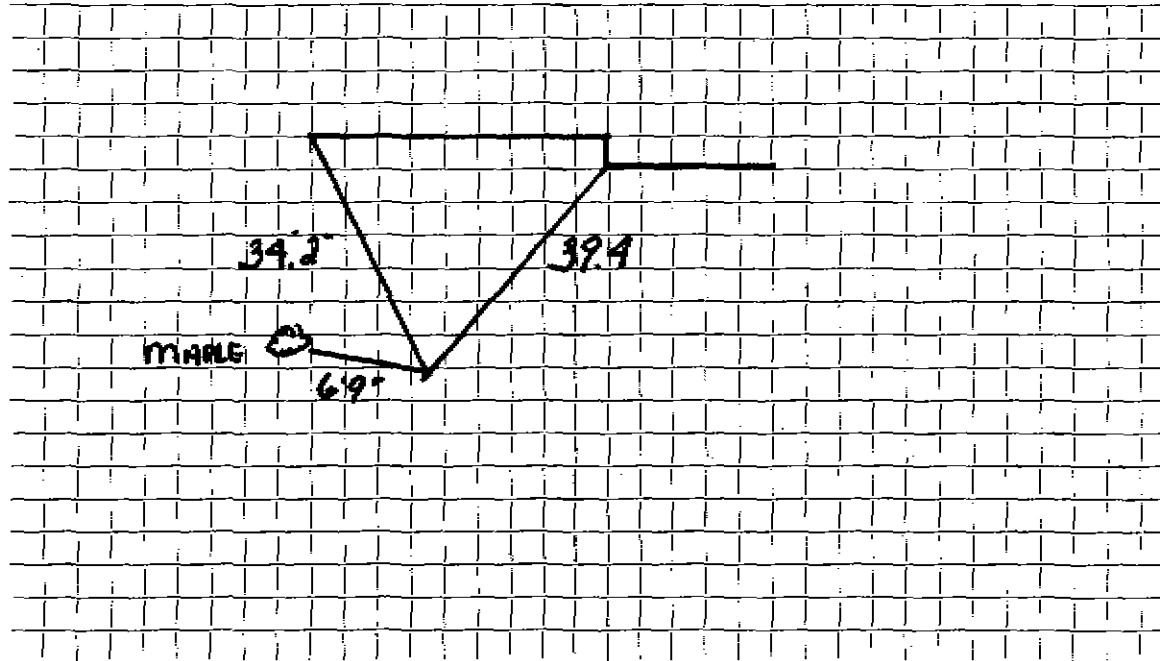

Connection made in Street. Work completed

Remarks:
.....
.....