

WATER SERVICE RECORD

Name *Heidke Realty Trust*

Service No. _____

Address *# 2 BATTLEVIEW CIR*

Location _____


~~Repair-Renewal~~ ~~Renewal~~ ~~New Service~~ *Arlex #3772*

Date	Material	Amount	Total	Date	Material	Amount	Total
1/14/83	59' x 1" Copper tubing						
	1 1" x 3 Part Union						
					<i>OUTSIDE</i>		
				1/14/83	85' x 1" Copper tubing		
					1 1" Curb Cock		
					1 1" Corp. Cock		
					1 Box & Rod		

DATE 10-8-82

TOWN OF LEXINGTON — BOARD OF PUBLIC WORKS
WATER DIVISION

Sketch of Service Here

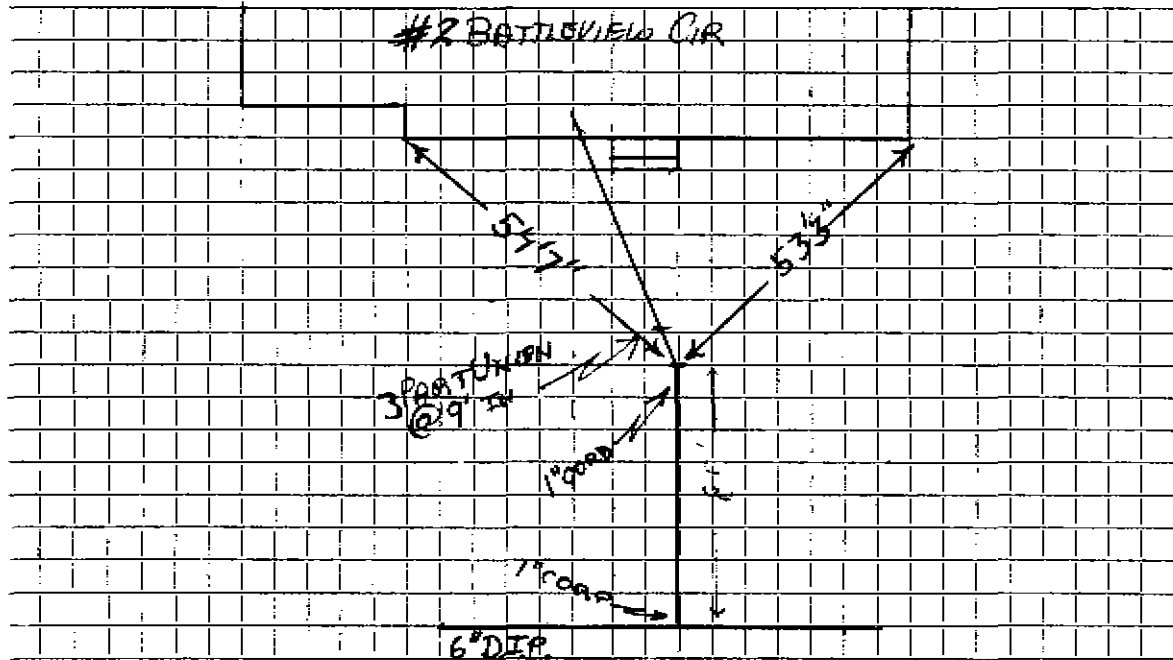

Connection made in BATTLEVIEW CIR Street. Work completed

Remarks:

.....

.....