


DATE 10-8-82

TOWN OF LEXINGTON — BOARD OF PUBLIC WORKS
WATER DIVISION

Sketch of Service Here

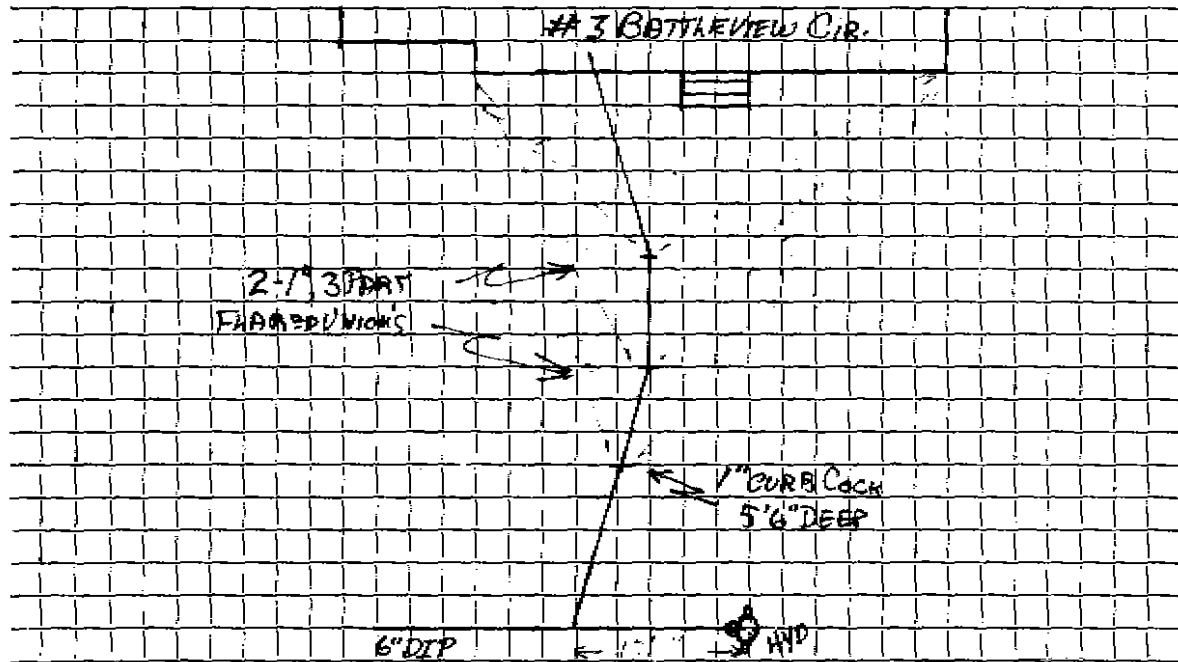

Connection made in BOTTLEVIEW CIR Street. Work completed 10-8-82

Remarks:

.....

.....