

WATER SERVICE RECORD

Name

Service No.

Address 10 Bedford Street

Location

Repair—Renewal—New Service


Kind of Pipe: Copper (type) Size: 1", Size of Main: 12" D.I.

Date	Material	Amount	Total	Date	Amount
11/4-58	40' 3/4" Copper			6/13/97	
	1 3/4" Cx 1/2 I.W.H. Stop+Waste			13'	3/4" copper
	+ <del>3/4" Stop 38 repair Clamp</del>			1	3/4" curb
	1 3/4" C. Union (2 part)				
	+ <del>3/4 x 5" C.L. Nipple</del>			11/1/2000	
				1	1" corporation off 12" main
				1	1" Union Copper x 3/4"
				20'	1" copper tubing

DATE 11-1-2000

TOWN OF LEXINGTON — BOARD OF PUBLIC WORKS  
WATER DIVISION

Sketch of Service Here

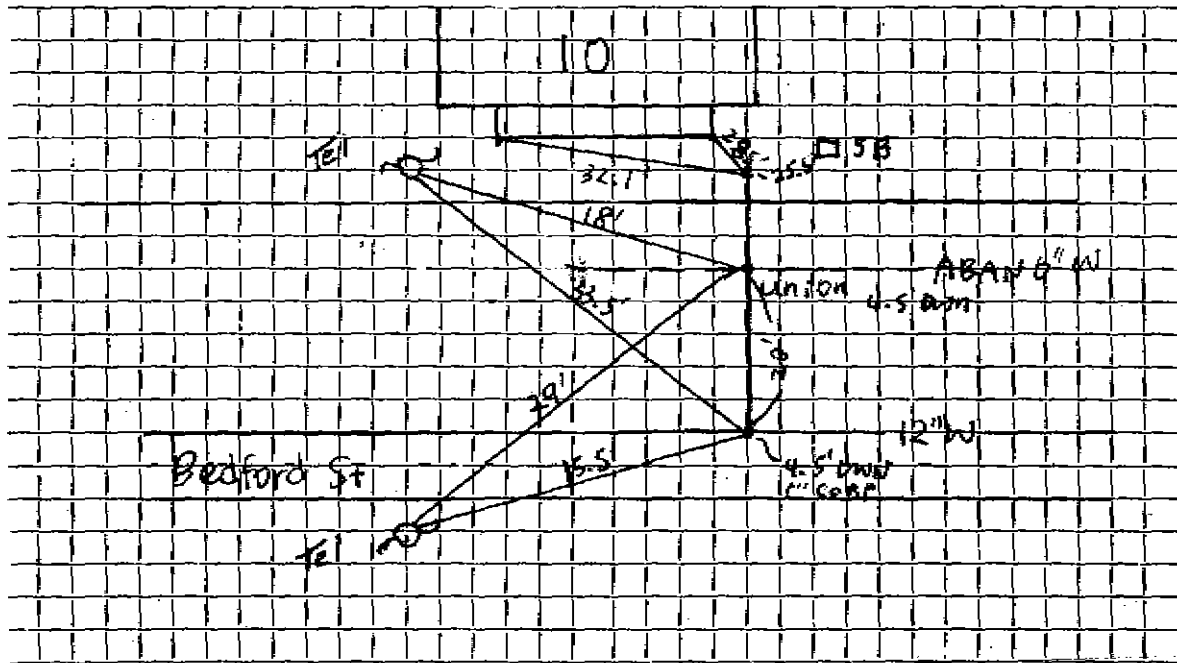

Connection made in Bedford St. (adjacent) Street. Work completed Granese & Sons, Inc. (Sub: deleted)  
Remarks: ... 6" main abandoned / s over to 12" main

Contract 00-12 field book #1 D. 2000

WATER SERVICE RECORD

Name Helen E. Ryan

Service No. 223

Address 10 Bedford Street

Location

Repair—Renewal—New Service—

Comm. 2/16/59


Date	Material	Amount	Total	Date	Amount
11/4/58	Labor	39 09		10/23/59	Deposit \$ 100 00
	10% overhead	3 91	43 00	2/16/59	Refund \$ 17 69
	40' - 3/4" Copper tubing @ .37		14 80		\$ 82 31
	1 - 3/4" Cx 1/2 I.W.H. Stop & Waste		5 84	6/13/97	13'-3/4" COPPER
	1 - 3/4" Style 38 Repair clamp		2 90	1	3/4" Corp
	1 - 3/4" C. Union (2 part)		1 24	1	3/4" Curb
	1 - 3/4x5" C.L. Nipple		28		
	3 hrs. Pippin Backhoe @ 4.50		13 50		
	1 hr. Trucking		75		
			82 31		

DATE \_\_\_\_\_

TOWN OF LEXINGTON — BOARD OF PUBLIC WORKS

WATER DIVISION

Sketch of Service Here

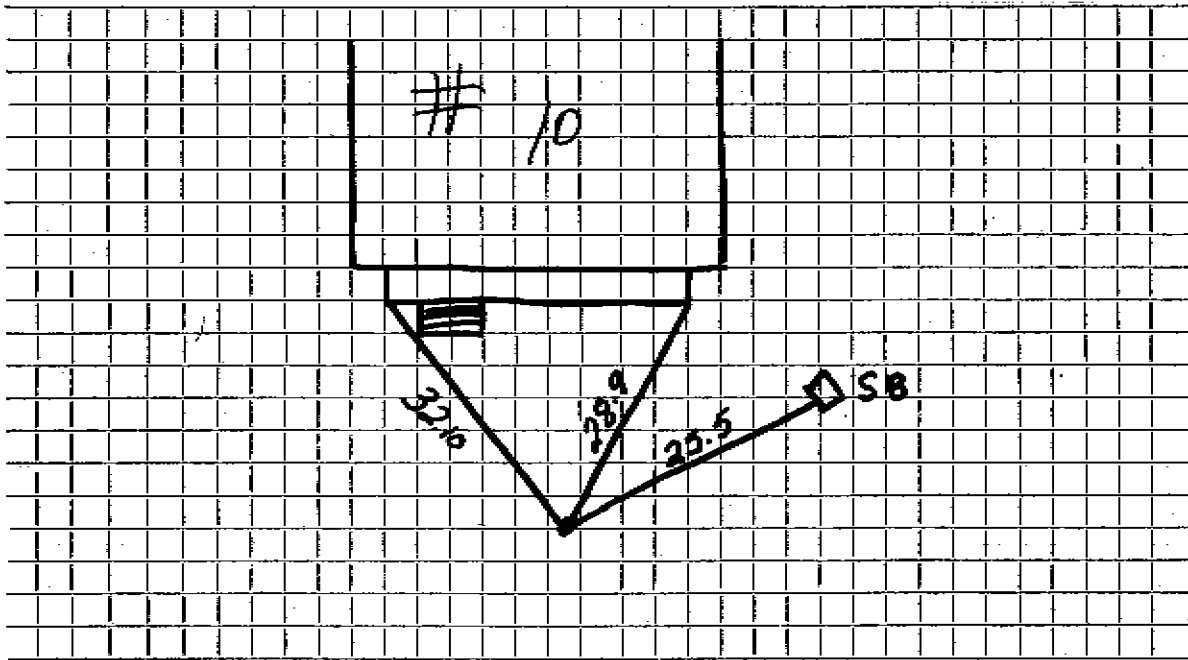

Connection made in ..... Street. Work completed .....

Remarks: .....

.....

.....