

WATER SERVICE RECORD

Name Ralph G. Semon

Service No. 27

Address 100 Bedford Street

Location

~~Repair~~ - Renewal - ~~New Service~~ W. O. # 9785

AUG 14 1972


| Date | Material | Amount | Total | Date | Amount |
|---------|--------------------------|--------|--------|---------|----------------------------|
| 6/13/72 | Labor | 99 68 | | 6-6-72 | Deposit 125 00 |
| 6/18/72 | " | 19 82 | | 8-30-72 | Paid 4 54 |
| | 10% O.H. | 11 95 | 131 45 | | 179 54 |
| 22' | 3/4" Copper pipe .79 | | 17 38 | | <u>OUTSIDE</u> |
| | 3/4" x 1/2" Stop & Waste | | 12 91 | 6/12/72 | Labor 114 76 |
| 1 | Yd. Loam | | 3 50 | 6/28/72 | " 35 27 |
| 3 | Hrs. Trucking 3.00 | | 9 00 | 22' | 3/4" Copper pipe .79 17 38 |
| 1 | Hr. Compressor | | 5 00 | | 3/4" Corp. adapter 2 91 |
| | | | 179 24 | | 3/4" Curb stop 11 32 |
| | | | | | Box & Rod 7 50 |
| | | | | 1 1/2 | Ton hot top 8.00 10 00 |
| | | | | 3 1/2 | Hrs. Trucking 3.00 4 50 |
| | | | | 2 | Hr. " 1.50 8 75 |
| | | | | 2 | Hrs. Shovel 4.00 8 00 |
| | | | | 1/2 | Hr. Compressor 3.00 1 50 |
| | | | | 1/2 | Hr. Loader 3.00 1 50 |
| | | | | 1/2 | Hr. Roller 2.00 1 00 |
| | | | | 1/2 | Hr. Trailer 2.00 -- 1 00 |
| | | | | | 217 39 |

DATE _____

TOWN OF LEXINGTON — BOARD OF PUBLIC WORKS

WATER DIVISION

Sketch of Service Here

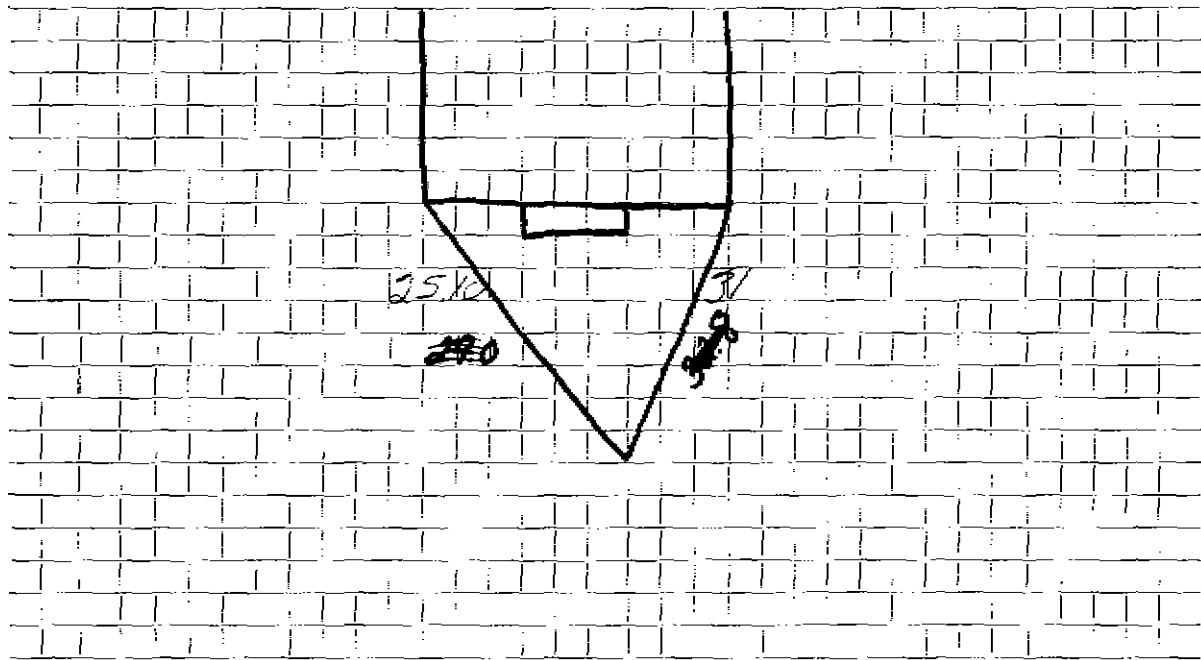

Connection made in Street. Work completed

Remarks:
.....
.....